

MAR 03 2000

1999 ALCONA COUNTY REMONUMENTATION CORNER

SECTION

LAND CORNER RECORDATION CERTIFICATE
Filing Requirement of Act 74, Mich. P.A. 1970

Alcona County
Remonumentation
Liber 2 Page 9

For corners in

<u>Alcona</u> (County)	Located In:	Corner Code #
1. Public Land Survey	T28N R5E	H-5
	T R	Mitchell Twp.
	T R	
	T R	
2. Property Controlling in Section	S T R	
	S T R	
3. Miscellaneous Property in Sec.	S T R	
	S T R	

Filed for Record in
ALCONA COUNTY MICHIGAN
DORIS A GAUTHIER
On 12-17-1999 At 10:07 am.
LAND CORNER 9.00

Register of Deeds Stamp & File Number

4. Lot No. _____, Recorded Plat _____
5. Private Claims _____

I, Thomas L. Fabis, in a field survey on Aug. 30, 1999 do hereby state that under requirements of P.A. 74, Michigan P.A. of 1970, the corner points mentioned in lines 1 and 2 above were in conformance with regulations and rules therefore as required in the current manual of survey instructions of the United States Department of the Interior, Bureau of Land Management or by a decree of a Court of Law and /or that the corner points mentioned in lines 3, 4 and 5 above were in conformance with the rules of the Michigan Board of Land Surveyors or by a Decree of a Court of Law; established, re-established, monumented, recovered, found as expressed below:

NOTE: Not more than 2 corners, all in the same town and range, may be recorded on this certificate.

A	B	C	D	E	F	G	H	I	J	K	L	M
1												
2	6	5			4		3		2		1	
3												
4	7	8			9		10		11		12	
5							●					
6	18	17			16		15		14		13	
7												
8	19	20			21		22		23		24	
9												
10	30	29			28		27		26		25	
11												
12	31	32			33		34		35		36	
13												

A. Description of original monument and accessories and/or subsequent restoration:

1840: G.L.O. Survey Thomas Pattison 10" Spruce Pine for 1/4 sec. post.
1991: Surveys Liber 245 Pages 565 & 567 Duane MacNeill set 1" Pipe & referenced:
P.P. N70W 74.70, Jack Pine N50W 84.12, Jack Pine N45E 74.57.

B. Description of corner evidence found and/or method applied in restoring or reestablishing corner:

1999: Found 1" Pipe I.D. in centerline of gravel road (Cemetery Rd.). Found one existing witness: Old shiner in P. Pole N70W 74.66'. Corner position indicates that it was set midway and on line between the two opposite section corners.

The position of this corner is compatible with local surveys and is accepted as a careful and faithful perpetuation of the position of the original corner.


C. Description of monument for corner and accessories established to perpetuate locating the position of the corner:

1999: Set 1/2" iron rod inside existing 1" pipe and capped it with a 3" dia. alum. cap, stamped to identify the corner. Witnesses are:
Exis. Shiner in P. Pole N70W 74.66
Set tag #31591 in 6" Oak N40W 84.27
Set tag #31591 in 3" J. Pine S65W 47.85
Set tag #31591 in Fe. Post N40E 40.20
D.R.M. iron pipe South 33.00

APPROVED LAND CORNER
P A 345 of 1990
ALCONA COUNTY
Date 9/23/99
County Rep. John B. Lewis

Signed by Thomas L. Fabis

Surveyor's Michigan License No. 31591

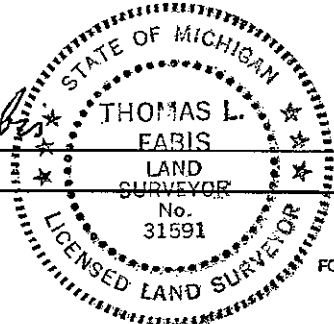

Date November 30, 1999