

MAR 03 2000

1999 Alcona County Remonumentation Corner
LAND CORNER RECORDATION CERTIFICATE
Filing Requirement of Act 74, Mich. P.A. 1970

SECTION

For corners in

Alcona

(County)

Located In:

Corner Code #

- 1. Public Land Survey T 28N R 5E H-7
 T R
 T R
 T R
- 2. Property Controlling S T R
 in Section S T R
- 3. Miscellaneous S T R
 Property in Sec. S T R

Alcona County
Remonumentation

Lib. 2 Page 31

U Filed for Record in
ALCONA COUNTY MICHIGAN
DORIS A GAUTHIER
On 12-17-1999 At 10:55 am.
LAND CORNER 9.00

Register of Deeds Stamp & File Number

- 4. Lot No. _____, Recorded Plat _____
- 5. Private Claims _____

I, Daniel T. Kibbe, in a field survey on June 2, 1999 do hereby state that under requirements of P.A. 74, Michigan P.A. of 1970, the corner points mentioned in lines 1 and 2 above were in conformance with regulations and rules therefore as required in the current manual of survey instructions of the United States Department of the Interior, Bureau of Land Management or by a decree of a Court of Law and /or that the corner points mentioned in lines 3, 4 and 5 above were in conformance with the rules of the Michigan Board of Land Surveyors or by a Decree of a Court of Law; established, re-established, monumented, recovered, found as expressed below:

NOTE: Not more than 2 corners, all in the same town and range, may be recorded on this certificate

A. Description of original monument and accessories and/or subsequent restoration:

- 1840: GLO Survey by Thos. Pattison-Set 1/4 post. Referenced: W. Pine 9-N36W-10/Y. Pine 16-S41E-32
- 1927: County Survey by W. S. Freer-Cedar stake 4"x4". Referenced: Y. Pine 9-N36W-10/Y. Pine 16-N25E-71
- 1990: Survey by Earl T. Lewis-Set 1/2" rod. Referenced: 10" Pine-S10W-46.8'8"/8"Pine-S20E-57.6'
- 1991: Survey by Duane R. MacNeill-Found 1/2" rerod.
- 1995: Survey by Mitchell & Associates-Found 1/2" rerod 5' North of CL Bugg Rd. Referenced: Found nail in 13" Red Pine-S39E-57.69'/Found nail in 12" Red Pine-S19W-46.75'/Set nail in 6" Oak-N37W-65.03'/Set nail in 10" Red Pine-N32E-57.01'

B. Description of corner evidence found and/or method applied in restoring or reestablishing corner:

- 1999: Remon. Survey by Daniel T. Kibbe-Found 1/2" rebar 2' deep, 5' North CL E-W road 2' West of fence to South.

This corner position is compatible with county & local surveys. This corner position is accepted as a careful and faithful perpetuation of the position of the original corner.

C. Description of monument for corner and accessories established to perpetuate locating the position of the corner:

- 1999: Placed 3" Alcona County cap stamped to identify the corner over 1/2" iron rod.


Referenced:

- 18" Twin Red Pine-set tag over nail-S37E 57.62'
- 20" Red Pine-set tag in old blaze-S23W 46.69'
- 16" Jack Pine-set tag-N20W 40.29'
- 10' Red Pine-found spike-N35E 56.89'
- 8" Oak-found spike-N40W 65.0'

	A	B	C	D	E	F	G	H	I	J	K	L	M
1													
2		6		5		4		3		2			1
3													
4		7		8		9		10		11			12
5													
6		10		17		16		15		14			13
7								●					
8		19		20		21		22		23			24
9													
10		30		29		28		27		26			25
11													
12		31		32		33		34		35			36
13													

APPROVED LAND CORNER
P A 345 of 1990
ALCONA COUNTY
Date: 9/23/99
County Rep. D. T. Kibbe

Signed by Daniel T. Kibbe
Surveyor's Michigan License No. 37278

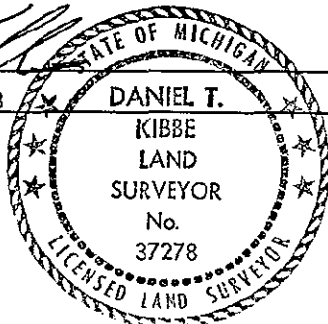

Date November 30, 1999