

MAR 03 2000

1999 ALCONA COUNTY REMONUMENTATION CORNER

SECTION

LAND CORNER RECORDATION CERTIFICATE
Filing Requirement of Act 74, Mich. P.A. 1970

Alcona County
Remonumentation
Liber 2 Page 6

For corners in

<u>Alcona</u> (County)	Located In:	Corner Code #
1. Public Land Survey	T <u>28NR 5E</u>	<u>I-1</u>
	T <u> </u> R <u> </u>	<u>Mitchell Twp.</u>
	T <u> </u> R <u> </u>	<u> </u>
	T <u> </u> R <u> </u>	<u> </u>
2. Property Controlling in Section	S <u> </u> T <u> </u> R <u> </u>	<u> </u>
	S <u> </u> T <u> </u> R <u> </u>	<u> </u>
3. Miscellaneous Property in Sec.	S <u> </u> T <u> </u> R <u> </u>	<u> </u>
	S <u> </u> T <u> </u> R <u> </u>	<u> </u>

Filed for Record in
ALCONA COUNTY MICHIGAN
DORIS A GAUTHIER
On 12-17-1999 At 10:07 am.
LAND CORNER 9.00

Register of Deeds Stamp & File Number

4. Lot No. _____, Recorded Plat _____
5. Private Claims _____

I, Thomas L. Fabis, in a field survey on Aug. 26, 1999 do hereby state that under requirements of P.A. 74, Michigan P.A. of 1970, the corner points mentioned in lines 1 and 2 above were in conformance with regulations and rules therefore as required in the current manual of survey instructions of the United States Department of the Interior, Bureau of Land Management or by a decree of a Court of Law and /or that the corner points mentioned in lines 3, 4 and 5 above were in conformance with the rules of the Michigan Board of Land Surveyors or by a Decree of a Court of Law; established, re-established, monumented, recovered, found as expressed below:

NOTE: Not more than 2 corners, all in the same town and range, may be recorded on this certificate.

A	B	C	D	E	F	G	H	I	J	K	L	M
1												
2	6	5	4	3	2	1						
3												
4	7	8	9	10	11	12						
5												
6	18	17	16	15	14	13						
7												
8	19	20	21	22	23	24						
9												
10	30	29	28	27	26	25						
11												
12	31	32	33	34	35	36						
13												

A. Description of original monument and accessories and/or subsequent restoration:
1840: G.L.O. Survey Thomas Pattison set post & referenced: Spr. Pine 16 S60W 22, do 8 S47E 25.
1913 & 1916: County Surveys W.S. Freer Cedar Stake 4x4 3 foot high.
1959 & 1960: M.D.O.T. Witness Card & Road Plans Norm Caldwell 1" Pipe & referenced.
1988: Survey Liber 218 Pages 604-5 Duane MacNeill measures to corner.
1996: Survey for Paul Morgan by John Oliver Found 1" Pipe.

B. Description of corner evidence found and/or method applied in restoring or reestablishing corner:
1999: Found 1" Pipe in centerline of gravel road (Doctor's Club Rd.). Also, found 1" Pipe 34.48 feet West. Also, found 3/4" iron pin 2.5 feet West and another 3/4" iron pin 36.84 feet West.


The position of this 1" Pipe is compatible with M.D.O.T., county and local surveys and is accepted as a careful and faithful perpetuation of the position of the original corner.

C. Description of monument for corner and accessories established to perpetuate locating the position of the corner:
1999: Set 1/2" iron rod inside existing 1" Pipe and capped with a 3" dia. alum. cap, stamped to identify the corner. Set tag #31591 in the following witnesses:
9" Oak N14W 29.67
7" Oak N36E 48.23
5" W. Pine S52E 35.85
6" J. Pine S22W 20.14

APPROVED LAND CORNER
P A 345 of 1990
ALCONA COUNTY

Date: 9/23/99
County Rep. D.P. W.

Signed by Thomas L. Fabis
Surveyor's Michigan License No. 31591

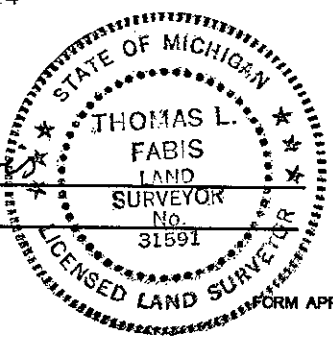

Date November 30, 1999