

MAR 09 2000

SECTION

1999 ALCONA COUNTY REMONUMENTATION CORNER

LAND CORNER RECORDATION CERTIFICATE  
Filing Requirement of Act 74, Mich. P.A. 1970

For corners in

Alcona (County)	Located In:	Corner Code #
1. Public Land Survey	T28NR 5E	I-3
	T__ R__	Mitchell Twp.
	T__ R__	
	T__ R__	
2. Property Controlling in Section	S__ T__ R__	
	S__ T__ R__	
3. Miscellaneous Property in Sec.	S__ T__ R__	
	S__ T__ R__	

Alcona County  
Remonumentation  
Liber 2 Page 2

Filed for Record in  
ALCONA COUNTY MICHIGAN  
DORIS A GAUTHIER  
On 12-17-1999 At 10:07 am.  
LAND CORNER 9.00

Register of Deeds Stamp & File Number

4. Lot No. \_\_\_\_\_, Recorded Plat \_\_\_\_\_  
5. Private Claims \_\_\_\_\_

I, Thomas L. Fabis, in a field survey on Aug. 26, 1999 do hereby state that under requirements of P.A. 74, Michigan P.A. of 1970, the corner points mentioned in lines 1 and 2 above were in conformance with regulations and rules therefore as required in the current manual of survey instructions of the United States Department of the Interior, Bureau of Land Management or by a decree of a Court of Law and /or that the corner points mentioned in lines 3, 4 and 5 above were in conformance with the rules of the Michigan Board of Land Surveyors or by a Decree of a Court of Law; established, re-established, monumented, recovered, found as expressed below:

NOTE: Not more than 2 corners, all in the same town and range, may be recorded on this certificate.

	A	B	C	D	E	F	G	H	I	J	K	L	M
1													
2		6		5		4		3		2		1	
3									●				
4		7		8		9		10		11		12	
5													
6		18		17		16		15		14		13	
7													
8		19		20		21		22		23		24	
9													
10		30		29		28		27		26		25	
11													
12		31		32		33		34		35		36	
13													

A. Description of original monument and accessories and/or subsequent restoration:

- 1840: G.L.O. Survey Thomas Pattison set post & referenced: Spr. Pine 8 S50W 18, Y. do 12 N55E 26.
- 1916 & 1926: County Surveys W.S. Freer 4x4 4 foot long Cedar Stake.
- 1959: M.D.O.T. Witness Card Norm Caldwell set Spring Leaf & referenced, according to directions set forth by Lyle MacDonald of Alcona Co. Rd. Comm.
- 1988: Survey Liber 218 Pages 604-5 D.R. MacNeill measures to corner.
- 1991: NELS Survey Bill Woods set 3/4" Pipe 3' West of Spring Leaf.

B. Description of corner evidence found and/or method applied in restoring or reestablishing corner:

- 1999: Found Spring Leaf 26' East of centerline of gravel rd. (Van Wagoner Rd.). New fence going East from corner. Also, found 3/4" pipe 3' West of Spring Leaf.


The position of the Spring Leaf is compatible with M.D.O.T. and County surveys and is accepted as a careful and faithful perpetuation of the position of the original corner.

C. Description of monument for corner and accessories established to perpetuate locating the position of the corner:

- 1999: Set 1/2" iron rod with 3" dia. alum. cap, stamped to identify the corner next to the existing Spring Leaf. Witnesses are:  
Existing Spike in 8" Bam. N30E 9.29  
Set tag #31591 in 5" Bam. S14E 3.23  
Set tag #31591 in Guard Post N88W 42.38  
Set tag #31591 in Guard Post N36W 56.65

APPROVED LAND CORNER  
P A 345 of 1990  
ALCONA COUNTY  
Date: 9/23/99  
County Rep. [Signature]

Signed by Thomas L. Fabis  
Surveyor's Michigan License No. 31591

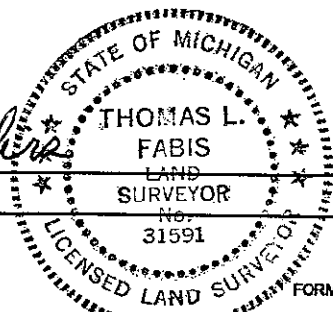

Date November 30, 1999