

MAR 03 2000

1999 ALCONA COUNTY REMONUMENTATION CORNER

LAND CORNER RECORDATION CERTIFICATE
Filing Requirement of Act 74, Mich. P.A. 1970

Alcona County
Remonumentation
Liber 2 Page 4

SECTION
For corners in

Alcona (County)	Located In:	Corner Code #
1. Public Land Survey	T <u>28</u> NR <u>5E</u>	I-4
	T ___ R ___	<u>Mitchell Twp.</u>
	T ___ R ___	_____
	T ___ R ___	_____
2. Property Controlling in Section	S ___ T ___ R ___	_____
	S ___ T ___ R ___	_____
3. Miscellaneous Property in Sec.	S ___ T ___ R ___	_____
	S ___ T ___ R ___	_____

Filed for Record in
ALCONA COUNTY MICHIGAN
DORIS A GAUTHIER
On 12-17-1999 At 10:07 am.
LAND CORNER 9.00

Register of Deeds Stamp & File Number

4. Lot No. _____, Recorded Plat _____
5. Private Claims _____

I, Thomas L. Fabis, in a field survey on Aug. 26, 1999 do hereby state that under requirements of P.A. 74, Michigan P.A. of 1970, the corner points mentioned in lines 1 and 2 above were in conformance with regulations and rules therefore as required in the current manual of survey instructions of the United States Department of the Interior, Bureau of Land Management or by a decree of a Court of Law and /or that the corner points mentioned in lines 3, 4 and 5 above were in conformance with the rules of the Michigan Board of Land Surveyors or by a Decree of a Court of Law; established, re-established, monumented, recovered, found as expressed below:

NOTE: Not more than 2 corners, all in the same town and range, may be recorded on this certificate.

	A	B	C	D	E	F	G	H	I	J	K	L	M
1													
2		6		5		4		3		2		1	
3													
4		7		8		9		10	●	11		12	
5													
6		18		17		16		15		14		13	
7													
8		19		20		21		22		23		24	
9													
10		30		29		28		27		26		25	
11													
12		31		32		33		34		35		36	
13													

A. Description of original monument and accessories and/or subsequent restoration:

- 1840: G.L.O. Survey Thomas Pattison set post & referenced: Spr. Pine 4 N22E 27, do 5 S10W 38.
- 1916: County Survey W.S. Freer Cedar 4x4 4 foot long.
- 1959: MDOT Witness Card Norm Caldwell found 1 1/4" pipe & crockery in West track of trail road & referenced.
- 1991: NELS Survey Bill Woods set 1/2" Bar & Cap and referenced.

B. Description of corner evidence found and/or method applied in restoring or reestablishing corner:

- 1999: Found 1/2" iron rod & cap NELS 7' West of centerline of gravel road in West track. Also found two existing witnesses as per Bill Woods Survey.

The position of this corner is compatible with local and MDOT surveys and is accepted as a careful and faithful perpetuation of the position of the original corner.


C. Description of monument for corner and accessories established to perpetuate locating the position of the corner:

- 1999: Removed NELS cap from existing 1/2" iron rod and replaced with 3" dia. alum. cap, stamped to identify the corner. Witnesses are:
 Exis. Spike in 12" R. Pine N74W 21.69
 Exis. Spike in 12" R. Pine N25W 37.22
 Set tag #31591 in 7" R. Pine N40E 32.68
 Set tag #31591 in 5" Oak S30W 41.61

APPROVED LAND CORNER
P A 345 of 1990
ALCONA COUNTY

Date: 9/23/99
County Rep. Del B. [Signature]

Signed by Thomas L. Fabis
Surveyor's Michigan License No. 31591

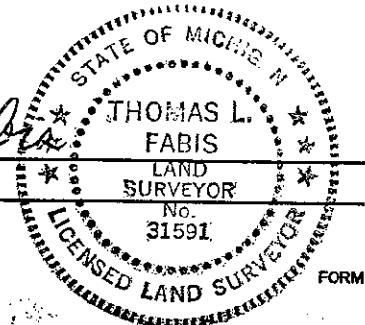

Date November 30, 1999