

SURVEY & REMONUMENTATION

MAR 04 1998

1997 ALCONA COUNTY REMONUMENTATION CORNER

Alcona County Remonumentation Liber 1 Page 237

LAND CORNER RECORDATION CERTIFICATE
Filing Requirement of Act 74, Mich. P.A. 1970

SECTION

For corners in Alcona
(County)

Located In:

Corner Code #

RECORDED


August 25 1:00 P.M. 97

- | | | |
|--------------------------------------|--------------------------|-----------------------|
| 1. Public Land Survey | T <u>28N</u> R <u>7E</u> | <u>E-3</u> |
| | T _____ R _____ | <u>Caledonia Twp.</u> |
| | T _____ R _____ | _____ |
| | T _____ R _____ | _____ |
| 2. Property Controlling in Section | S _____ T _____ R _____ | _____ |
| | S _____ T _____ R _____ | _____ |
| 3. Miscellaneous Property in Section | S _____ T _____ R _____ | _____ |
| | S _____ T _____ R _____ | _____ |

APPROVED LAND CORNER
P A 345 of 1990
ALCONA COUNTY
Date 8/17/97
County Rep. D.M. C.

David A. Heather
REGISTER OF DEEDS
Register of Deeds Stamp & File Number

4. Lot No. _____, Recorded Plat _____
5. Private Claims _____

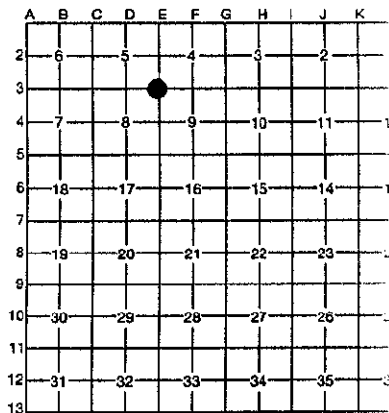

I, Thomas L. Fabis, in a field survey on June 12, 19 97, do hereby certify that under requirements of P.A. 74, Michigan P.A. of 1970, the corner points mentioned in lines 1 and 2 above were in conformance with regulations and rules therefore as required in the current manual of survey instructions of the United States Department of the Interior, Bureau of Land Management or by a decree of a Court of Law and/or that the corner points mentioned in lines 3, 4 and 5 above were in conformance with the rules of the Michigan Board of Professional Surveyors or by a Decree of a Court of Law; established, re-established, monumented, re-monumented, recovered, found as expressed below:

NOTE: Not more than 4 corners, all in the same town and range, may be recorded on this certificate.


- A. Description of original monument and accessories and/or subsequent restoration:**
 1840: G.L.O. Survey Thomas Pattison Set post & referenced: Hem 9 N42W 83, Fir 8 S37E 19
 1903: County Survey W. Chapelle Found post & referenced.
 1912: Highway Survey Jos. McNeil Used corner.
 1968: Survey (L.137 P.964) James Scott Used corner.
 1980 thru 1989: Surveys Duane MacNeill (L.188 P.95, L.189 P.149, L.218 P's.630,632,635,&638, L.193 P's.925,926&927, L.227 P.656) Found "T" Bar & referenced.
 1986: Survey W.O. 1-1411 David Guthrie Found "T" Iron & referenced.
 1988: N.E.L.S. Survey (L.218 P.308) John Oliver Found "T" iron.
 1993 & 1994: Surveys W.O. 1-242 & 1-264 Earl Lewis Found "T" Iron & referenced.
 1996: Survey (L.296 P.545) John Oliver Found "T" Iron.

- B. Description of corner evidence found and/or method applied in restoring or reestablishing corner:**
 1997: Found "T" Iron and 4 witnesses: Lewis tag in 30" W. Spruce N78W 47.67', Shiner in P.P. N40E 34.93', Shiner in P. Pole S85W 30.35', Conc. Mon. East 33.04', indicating this is the same corner position used by the surveyors mentioned above.

The position of this corner is accepted as a careful and faithful perpetuation of the position of the original corner.

- C. Description of monument for corner and accessories established to perpetuate locating the position of the corner:**
 1997: Removed the existing "T" iron and set in its place a 1/2" iron rod with a 3" dia. brass cap, stamped to identify the corner, and set a Monument Box around the corner.

- References:
 Lewis tag in 30" W. Spruce - N78W - 47.67'
 Shiner in P.P. - N40E - 34.93'
 Shiner in P.P. - S85W - 30.35'
 Set tag P.S. #31591 in 24" W. Pine - S40E - 46.48'
 Conc. Mon. - East - 33.04'

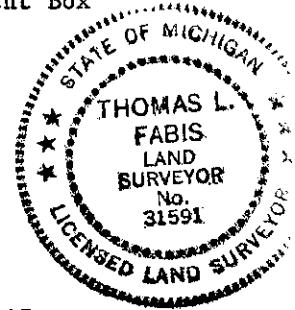

Signed by Thomas L. Fabis Date August 15, 1997
 Surveyor's Michigan License No. 31591