

SURVEY & REMONUMENTATION

MAR 04 1998

1997 ALCONA COUNTY REMONUMENTATION CORNER

Alcona County Remonumentation
Liber 1 Page 236

SECTION

LAND CORNER RECORDATION CERTIFICATE

Filing Requirement of Act 74, Mich. P.A. 1970


For corners in	Located in:	Corner Code #
Alcona (County)		
1. Public Land Survey	T <u>28N</u> R <u>7E</u>	<u>E-4</u>
	T _____ R _____	<u>Caledonia Twp.</u>
	T _____ R _____	_____
	T _____ R _____	_____
2. Property Controlling in Section	S _____ T _____ R _____	_____
	S _____ T _____ R _____	_____
3. Miscellaneous Property in Section	S _____ T _____ R _____	_____
	S _____ T _____ R _____	_____

APPROVED LAND CORNER
P.A. 345 of 1990
ALCONA COUNTY
Date: 8/13/97
County Rep [Signature]

RECORDED
August 25 1:00 P.M.

[Signature]
REGISTER OF DEEDS
Register of Deeds Stamp & File Number

- 4. Lot No. _____, Recorded Plat _____
- 5. Private Claims _____

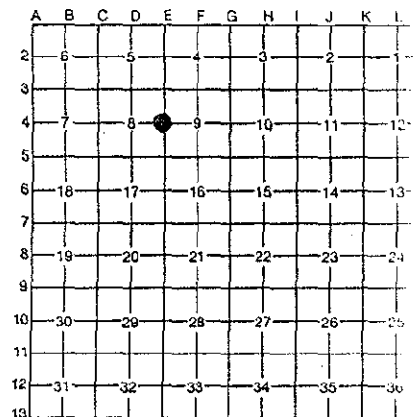

I, Thomas L. Fabis, in a field survey on June 12, 1997, do hereby certify that under requirements of P.A. 74, Michigan P.A. of 1970, the corner points mentioned in lines 1 and 2 above were in conformance with regulations and rules therefore as required in the current manual of survey instructions of the United States Department of the Interior, Bureau of Land Management or by a decree of a Court of Law and/or that the corner points mentioned in lines 3, 4 and 5 above were in conformance with the rules of the Michigan Board of Professional Surveyors or by a Decree of a Court of Law; established, re-established, monumented, re-monumented, recovered, found as expressed below:


NOTE: Not more than 4 corners, all in the same town and range, may be recorded on this certificate.

A. Description of original monument and accessories and/or subsequent restoration:
 1840: G.L.O. Survey Thomas Pattison Set post & referenced: Y. Pine 20 S52E 27, No other.
 1980 thru 1985: Surveys by Duane MacNeill (L.188 P.95, L.193 P.928, L.189 P.149, L.218 P.638, L.193 P.927, L.218 P.635 & L.218 P.632). Found iron & referenced.
 1986: Survey W.O. 1-1411 David Guthrie Found 1/2" iron rod & referenced.
 1993: Survey W.O. 1-242 Earl Lewis Referenced corner.

B. Description of corner evidence found and/or method applied in restoring or reestablishing corner:
 1997: Found 1/2" iron at inters. of centerline of N-S paved road and E-W fence lines. Found 2 witnesses with shiners: (S40W Utility Pole 43.65', N88E Fe. Po. 30.55') and 2 other existing witness trees: (14" Oak N75W 55.81', 13" Scotch Pine N80E 33.38') indicating this is the same corner position used by the surveyors mentioned above.

The position of this corner is accepted as a careful and faithful perpetuation of the position of the original corner.

C. Description of monument for corner and accessories established to perpetuate locating the position of the corner:
 1997: Set 3" dia. brass cap, stamped to identify the corner over the existing 1/2" iron rod and set a Monument Box around the corner.
 Set tag P.S. #31591 in the following witnesses:
 14" Oak - N75W - 55.81'
 13" Scotch Pine - N80E - 33.38'
 6" W. Pine - S55E - 33.18'
 Pole - Due West - 27.22'
 Existing shiner in Fe. Post - N88E - 30.55'
 Existing shiner in Utility Pole - S40W - 43.65'

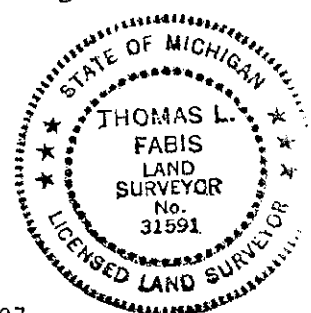

Signed by Thomas L. Fabis Date August 15, 1997
 Surveyor's Michigan License No. 31591

FORM APPROVED BY MICHIGAN STATE BOARD OF PROFESSIONAL SURVEYORS, JAN. 28, 1971
 REVISED MAY 14, 1972
 REVISED JAN, 1985

SURVEY & REMONUMENTATION

NOV 14 1997

COMMISSION