

**SURVEY & REMONUMENTATION**

MAR 04 1998

1997 ALCONA COUNTY REMONUMENTATION CORNER

Alcona County Remonumentation  
Liber 1 Page 240

SECTION

**LAND CORNER RECORDATION CERTIFICATE**  
Filing Requirement of Act 74, Mich. P.A. 1970

RECORDED

August 25, 1:00 p.m. 97

For corners in Alcona (County) Located In: \_\_\_\_\_ Corner Code # \_\_\_\_\_


1. Public Land Survey	T	<u>28N</u>	R	<u>7E</u>	<u>I-3</u>
	T	_____	R	_____	<u>Caledonia Twp.</u>
	T	_____	R	_____	_____
	T	_____	R	_____	_____
2. Property Controlling in Section	S	_____	T	_____	_____
	S	_____	T	_____	_____
3. Miscellaneous Property in Section	S	_____	T	_____	_____
	S	_____	T	_____	_____

4. Lot No. \_\_\_\_\_, Recorded Plat \_\_\_\_\_

5. Private Claims \_\_\_\_\_

APPROVED LAND CORNER  
P A 345 of 1990  
ALCONA COUNTY  
Date: 8/13/97  
County Rep. [Signature]

[Signature]  
REGISTER OF DEEDS  
Register of Deeds Stamp & File Number

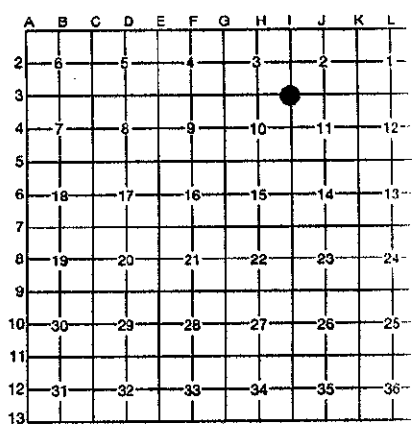

I, Thomas L. Fabis, in a field survey on June 12, 1997, do hereby certify that under requirements of P.A. 74, Michigan P.A. of 1970, the corner points mentioned in lines 1 and 2 above were in conformance with regulations and rules therefore as required in the current manual of survey instructions of the United States Department of the Interior, Bureau of Land Management or by a decree of a Court of Law and/or that the corner points mentioned in lines 3, 4 and 5 above were in conformance with the rules of the Michigan Board of Professional Surveyors or by a Decree of a Court of Law; established, re-established, monumented, re-monumented, recovered, found as expressed below:


**NOTE: Not more than 4 corners, all in the same town and range, may be recorded on this certificate.**

- A. Description of original monument and accessories and/or subsequent restoration:**  
 1840: G.L.O. Survey Thomas Pattison Set post & referenced: Y. Pine 20 S27W 62, Do 18 S18E  
 1902: County Survey Ed Chapelle Set post.  
 1985: Survey (L.218 P.617) Duane MacNeill Ties to corner from East.  
 1987: Survey (L.218 P.616) Duane MacNeill Ties to corner from North & East.  
 1989: Survey (L.224 P.329) Duane MacNeill Found 1" Iron Pipe & ties to corner from West.

- B. Description of corner evidence found and/or method applied in restoring or reestablishing corner:**  
 1997: Found 1" Iron Pipe capped P.S. 19237 at intersection of fences to the North and to the West.

The position of this corner is compatible with county and local surveys and is accepted as a careful and faithful perpetuation of the position of the original corner.

- C. Description of monument for corner and accessories established to perpetuate locating the position of the corner:**  
 1997: Set 1/2" iron rod with 3" dia. alum. cap, stamped to identify the corner inside the existing 1" Iron Pipe.  
 Set tags P.S. #31591 in the following reestablished witnesses:  
 16" Oak - West - 14.03'  
 6" Maple - S10W - 26.54'  
 6" R. Pine - N30E - 40.14'  
 6" Oak - N10E - 40.79'

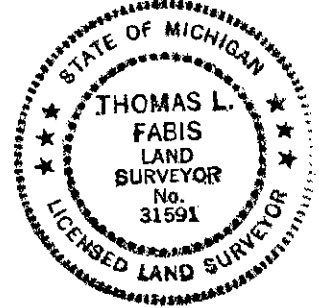

Signed by Thomas L. Fabis Date August 15, 1997  
 Surveyor's Michigan License No. 31591