

**SURVEY & REMONUMENTATION**

MAR 04 1998

1997 ALCONA COUNTY REMONUMENTATION CORNER

Alcona County  
Remonumentation  
Liber 7 Page 232

**SECTION**

**LAND CORNER RECORDATION CERTIFICATE**  
Filing Requirement of Act 74, Mich. P.A. 1970

For corners in Alcona  
(County)

Located In:

Corner Code #

- |                                      |                          |                |
|--------------------------------------|--------------------------|----------------|
| 1. Public Land Survey                | T <u>28N</u> R <u>7E</u> | J-3            |
|                                      | T _____ R _____          | Caledonia Twp. |
|                                      | T _____ R _____          | _____          |
|                                      | T _____ R _____          | _____          |
| 2. Property Controlling in Section   | S _____ T _____ R _____  | _____          |
|                                      | S _____ T _____ R _____  | _____          |
| 3. Miscellaneous Property in Section | S _____ T _____ R _____  | _____          |
|                                      | S _____ T _____ R _____  | _____          |


APPROVED LAND CORNER  
P.A. 345 of 1990  
ALCONA COUNTY  
Date 8/17/97  
County Rep. [Signature]

RECORDED  
August 25, 1:00 P.M.

[Signature]  
REGISTER OF DEEDS  
Register of Deeds Stamp & File Number

4. Lot No. \_\_\_\_\_, Recorded Plat \_\_\_\_\_  
5. Private Claims \_\_\_\_\_

I, Thomas L. Fabis, in a field survey on June 12, 1997, do hereby certify that under requirements of P.A. 74, Michigan P.A. of 1970, the corner points mentioned in lines 1 and 2 above were in conformance with regulations and rules therefore as required in the current manual of survey instructions of the United States Department of the Interior, Bureau of Land Management or by a decree of a Court of Law and/or that the corner points mentioned in lines 3, 4 and 5 above were in conformance with the rules of the Michigan Board of Professional Surveyors or by a Decree of a Court of Law; established, re-established, monumented, re-monumented, recovered, found as expressed below:

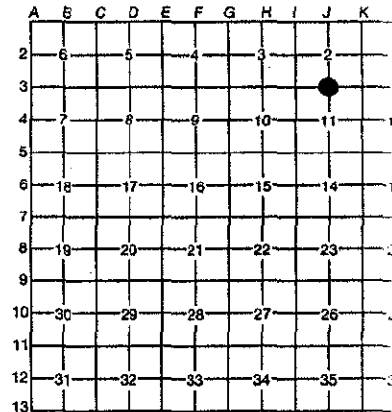

**NOTE: Not more than 4 corners, all in the same town and range, may be recorded on this certificate.**

**A. Description of original monument and accessories and/or subsequent restoration:**

- 1840: G.L.O. Survey Thomas Pattison Set post & referenced: Y. Pine 24 S58E 42, Do 18 N70W 55
- 1902: County Survey Ed Chapelle Set 1/4 post & referenced.
- 1977: R.S. Scott Corner Records Gives corner witnesses: N50W - 10" Oak - 43.80', N45E - 18" Oak - 53.15', S15E - 14" Maple - 54.10', S.E. - Conc. Fe. Po. - 42.8'
- 1985: Survey (L. 218 P. 617) Duane MacNeill Makes tie to North & West.
- 1987: Survey (L. 218 P. 616) Duane MacNeill Makes tie to North & West.


**B. Description of corner evidence found and/or method applied in restoring or reestablishing corner:**

- 1997: Found 1/2" iron rod and 2 existing witness trees: N40E - 24" Oak 53.15', S22E - 16" Oak 54.10'

The position of this corner is compatible with the local surveys mentioned above and is accepted as a careful and faithful perpetuation of the position of the original corner.

**C. Description of monument for corner and accessories established to perpetuate locating the position of the corner:**

- 1997: Set 3" dia. alum. cap, stamped to identify the corner over the existing 1/2" iron rod at intersection of gravel roads.
- Witnesses are:
  - 24" Oak - N40E - 53.15'
  - 16" Oak - S22E - 54.10'
  - 8" Oak - N55W - 71.00'
  - Anchor Pole - S50W - 49.50'

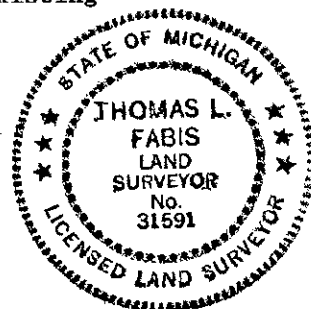

Signed by Thomas L. Fabis Date August 15, 1997  
Surveyor's Michigan License No. 31591