

SURVEY & REMONUMENTATION

MAR 04 1998

1997 ALCONA COUNTY REMONUMENTATION CORNER
LAND CORNER RECORDATION CERTIFICATE
 Filing Requirement of Act 74, Mich. P.A. 1970

Alcona County Remonumentation
 Liber 1 Page 239

SECTION

For corners in	<u>Alcona</u> (County)	Located In:	Corner Code #
1. Public Land Survey	T <u>28N</u> R <u>7E</u>		<u>L-3</u>
	T _____ R _____		<u>Caledonia Twp.</u>
	T _____ R _____		_____
	T _____ R _____		_____
2. Property Controlling in Section	S _____ T _____ R _____		_____
	S _____ T _____ R _____		_____
3. Miscellaneous Property in Section	S _____ T _____ R _____		_____
	S _____ T _____ R _____		_____

APPROVED LAND CORNER
 P.A. 345 of 1990
 ALCONA COUNTY
 Date: 8/15/97
 County Rep. _____

RECORDED
 August 25 1:00 p.m. 97

Eric A. Heather
 REGISTER OF DEEDS
 Register of Deeds Stamp & File Number

4. Lot No. _____, Recorded Plat _____
 5. Private Claims _____

A	B	C	D	E	F	G	H	I	J	K	L
2	6	5	4	3	2						
3											
4	7	6	5	4	3	2	1				
5											
6	18	17	16	15	14	13	12	11	10	9	8
7											
8	19	20	21	22	23	24	25	26	27	28	29
9											
10	30	29	28	27	26	25	24	23	22	21	20
11											
12	31	32	33	34	35	36	37	38	39	40	41
13											

I, Thomas L. Fabis, in a field survey on June 12, 1997, do hereby certify that under requirements of P.A. 74, Michigan P.A. of 1970, the corner points mentioned in lines 1 and 2 above were in conformance with regulations and rules therefore as required in the current manual of survey instructions of the United States Department of the Interior, Bureau of Land Management or by a decree of a Court of Law and/or that the corner points mentioned in lines 3, 4 and 5 above were in conformance with the rules of the Michigan Board of Professional Surveyors or by a Decree of a Court of Law; established, re-established, monumented, re-monumented, recovered, found as expressed below:


NOTE: Not more than 4 corners, all in the same town and range, may be recorded on this certificate.

- A. Description of original monument and accessories and/or subsequent restoration:**
 1840: G.L.O. Survey Thomas Pattison Set Post & referenced: Cedar 10 N36E 4, Spruce 8 S81W 33
 1985: Survey L. 218 P. 614 Duane MacNeill Makes tie to the North.
 1987: Survey L. 208 P's. 201 & 202 David Guthrie Set 1/2" iron rod at inters. Spruce Rd. West and fence North & referenced: S75E 5" Balsam 22.55', S30E 4" Balsam 21.35', S25W 30" Birch 53.75'
 1990: Survey W.O. 1-98 Earl Lewis Found 1/2" Rod and referenced.
 1994: Survey W.O. 1-297 Earl Lewis Found 1/2" Rod and referenced.

- B. Description of corner evidence found and/or method applied in restoring or reestablishing corner:**
 1997: Found 1/2" iron rod P.S. 22435 at inters. fence wire South and centerline of Spruce Rd. West. Found 1/2" iron rod P.S. 22435 10.55' South and two witnesses: S65W 30" Birch 53.65' and S40E 6" Balsam 21.15'

The position of this corner is compatible with the local surveys mentioned above and is accepted as a careful and faithful perpetuation of the position of the original corner.

- C. Description of monument for corner and accessories established to perpetuate locating the position of the corner:**
 1997: Set 3" dia. alum. cap, stamped to identify the corner over existing 1/2" iron rod. Witnesses are:
 30" Birch - S65W - 53.65'
 5" Balsam - S15W - 23.56'
 6" Balsam - S40E - 21.15'
 8" Cedar - N40W - 67.52'
 1/2" iron rod P.S. 22435 - South - 10.55'

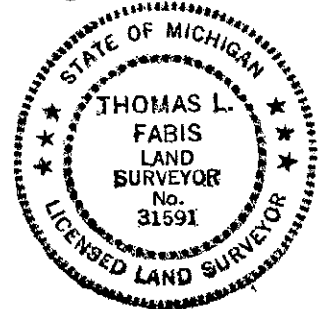

Signed by Thomas L. Fabis Date August 15, 1997

Surveyor's Michigan License No. 31591 FORM APPROVED BY MICHIGAN STATE BOARD OF PROFESSIONAL SURVEYORS, JAN. 28, 1971 REVISED MAY 14, 1975 REVISED JAN., 1983