

SURVEY & REMONUMENTATION

MAR 04 1998

1997 ALCONA COUNTY REMONUMENTATION CORNER

Alcona County
Remonumentation
Liber 1 Page 245

LAND CORNER RECORDATION CERTIFICATE

Filing Requirement of Act 74, Mich. P.A. 1970

SECTION

For corners in Alcona
(County)

Located in:

Corner Code #

1. Public Land Survey

T 27N R 7E
T _____ R _____
T _____ R _____
T 27N R 8E

M-1
Hawes Twp.

2. Property Controlling in Section

S _____ T _____ R _____
S _____ T 27N R 7E

A-1
Hawes Twp.

3. Miscellaneous Property in Section

S _____ T 27N R R8E
S _____ T _____ R _____

M-13 Alcona
A-13 Twp.

APPROVED LAND CORNER
P A 345 of 1990
ALCONA COUNTY
Date 8/15/97
County Rep [Signature]

RECORDED
August 25, 1:00 P.M. 97

[Signature]
REGISTER OF DEEDS
Register of Deeds Stamp & File Number

4. Lot No. _____, Recorded Plat _____
5. Private Claims _____

	A	B	C	D	E	F	G	H	I	J	K	L
2	6		5		4		3		2		1	
3												
4	7		6		5		4		3		2	
5												
6	18		17		16		15		14		13	
7												
8	19		20		21		22		23		24	
9												
10	30		29		28		27		26		25	
11												
12	31		32		33		34		35		36	
13												

I, Thomas L. Fabis, in a field survey on June 12, 1997
do hereby certify that under requirements of P.A. 74, Michigan P.A. of 1970, the corner points mentioned in lines 1 and 2 above were in conformance with regulations and rules therefore as required in the current manual of survey instructions of the United States Department of the Interior, Bureau of Land Management or by a decree of a Court of Law and/or that the corner points mentioned in lines 3, 4 and 5 above were in conformance with the rules of the Michigan Board of Professional Surveyors or by a Decree of a Court of Law; established, re-established, monumented, re-monumented, recovered, found as expressed below:

NOTE: Not more than 4 corners, all in the same town and range, may be recorded on this certificate.

A. Description of original monument and accessories and/or subsequent restoration:

- 1838: G.L.O. Survey Lewis Clason Set post & referenced: (Cedar 9 N44W 19, Fir 11 S48E 18)
- 1973: Survey L.151 P.251 James Scott Makes tie to corner from M-2, T27N, R7E.
- 1976: Survey L.161 P.342 John Oliver Found 1" Iron.
- 1979: Surveys L.173 P's. 965 & 966, & L.173 P.968 Duane MacNeill Found 4" x 4" cedar stake & 1" Pipe and referenced: N55E 34.30' 7" Cedar, S50E 34.68' 7" Balsam, Due West 29.16' Fe. Po.


B. Description of corner evidence found and/or method applied in restoring or reestablishing corner:

- 1997: Found no corner monumentation, except 2 existing witnesses: 7" Blazed Cedar - N70E - 34.58 and 7" Blazed Tam. - S75E - 29.00. Re-set corner using Survey Liber 173 Page 965 by Duane MacNeill for reference.

The position of this corner is compatible with the local surveys mentioned above and is accepted as careful and faithful perpetuation of the position of the original corner.

C. Description of monument for corner and accessories established to perpetuate locating the position of the corner:

- 1997: Set 1/2" iron rod with 3" dia. alum. cap, stamped to identify the corner, 20 feet East of Power Line and 11 feet South of Hunting Wire.
Set tags #31591 in the following witnesses:
7" Blazed Cedar - N70E - 34.58'
7" Blazed Tam. - S75E - 29.00'
5" Balsam - N10W - 14.38'
8" Cedar - Due West - 74.13'

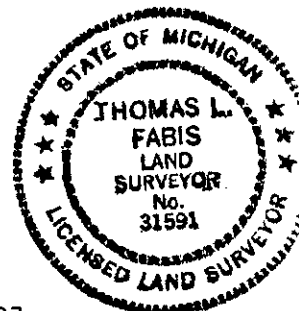

Signed by Thomas L. Fabis

Date August 15, 1997

Surveyor's Michigan License No. 31591