

**SURVEY & REMONUMENTATION**

RECORDED

1994 Alcona County Remonumentation Corner

APR 23 1995

**LAND CORNER RECORDATION CERTIFICATE**  
Filing Requirement of Act 74, Mich. P.A. 1970

Nov 7 2 08 PM '94

**COMMISSION**

For corners in

<u>Alcona</u> (County)	Located In:	Corner Code #
1. Public Land Survey	T <u>28N</u> R <u>8E</u>	<u>B-3</u>
	T _____ R _____	_____
	T _____ R _____	_____
	T _____ R _____	_____
2. Property Controlling in Section	S _____ T _____ R _____	_____
	S _____ T _____ R _____	_____
3. Miscellaneous Property in Sec.	S _____ T _____ R _____	_____
	S _____ T _____ R _____	_____

*Janis A. Smith*  
REGISTER OF DEEDS  
ALCONA COUNTY, MICHIGAN

Alcona County  
Remonumentation  
Liber 1 Page 65

E. T. L.

Register of Deeds Stamp & File Number

4. Lot No. \_\_\_\_\_, Recorded Plat \_\_\_\_\_  
5. Private Claims \_\_\_\_\_

A	B	C	D	E	F	G	H	I	J	K	L
2	6		5		4		3		2		1
3											
4	7		8		9		10		11		1
5											
6	18		17		16		15		14		1
7											
8	19		20		21		22		23		2
9											
10	30		29		28		27		26		2
11											
12	31		32		33		34		35		3
13											


I, David B. Guthrie in a field survey on May 26, 1994, do hereby certify that under requirements of P.A. 74, Michigan P.A. of 1970, the corner points mentioned in lines 1 and 2 above were in conformance with regulations and rules therefore as required in the current manual of survey instructions of the United States Department of the Interior, Bureau of Land Management or by a decree of a Court of Law and/or that the corner points mentioned in lines 3, 4 and 5 above were in conformance with the rules of the Michigan Board of Land Surveyors or by a Decree of a Court of Law; established, re-established, monumented, re-monumented, recovered, found as expressed below:

**NOTE: Not more than 4 corners, all in the same town and range, may be recorded on this certificate.**

- A. Description of original monument and accessories and/or subsequent restoration:  
1840: G.L.O. Survey by Thos. Pattison - Set post and referenced Fir 10 - S55E - 20 / Fir 10 - N50W - 44  
1903: Survey by Edward Chapelle - Found Cedar Post  
1977: Survey by David B. Guthrie - Found 1/2" Iron Rod

- B. Description of corner evidence found and/or method applied in restoring or reestablishing corner:  
1994: Found 1/2" Iron Rod in road intersection.

- C. Description of monument for corner and accessories established to perpetuate locating the position of the corner:  
1994: Replaced with 5/8" Iron Rod with a 3" Brass Cap stamped to identify the corner placed in a Monument Box.  
Referenced -  
S50°E - Utility Pole - 58.40 feet  
N71°E - 9" Elm - 60.78 feet  
N04°W - Sign Post - 37.23 feet  
S66°W - Sign Post - 103.40 feet

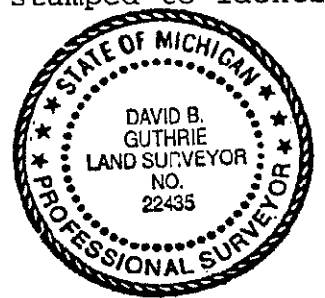

Signed by David B. Guthrie Date Nov. 5, 1994  
Surveyor's Michigan License No. 22435