

**2000 Alcona County Remonumentation Corner
LAND CORNER RECORDATION CERTIFICATE**
Filing Requirement of Act 74, Mich. P.A. 1970

For corners in

Alcona	Located In:	Corner Code #
(County)		
1. Public Land Survey	T 28N R8E	B-5 <input checked="" type="checkbox"/>
	T _____ R _____	_____
	T _____ R _____	_____
	T _____ R _____	_____
2. Property Controlling in Section	S _____ T _____ R _____	_____
	S _____ T _____ R _____	_____
3. Miscellaneous Property in Sec.	S _____ T _____ R _____	_____
	S _____ T _____ R _____	_____


Alcona County
Remonumentation
Liber 2 Page 59

0
Filed for Record in
ALCONA COUNTY MICHIGAN
DORIS A GAUTHIER
On 09-20-2000 At 09:36 am.
LAND CORNER 9.00

Register of Deeds Stamp & File
Number

4. Lot No. _____, Recorded Plat _____
5. Private Claims _____

I, Daniel T. Kibbe, in a field survey on April 7, 2000 do hereby state that under requirements of P.A. 74, Michigan P.A. of 1970, the corner points mentioned in lines 1 and 2 above were in conformance with regulations and rules therefore as required in the current manual of survey instructions of the United States Department of the Interior, Bureau of Land Management or by a decree of a Court of Law and for that the corner points mentioned in lines 3, 4 and 5 above were in conformance with the rules of the Michigan Board of Land Surveyors or by a Decree of a Court of Law; established, re-established, monumented, recovered, found as expressed below:

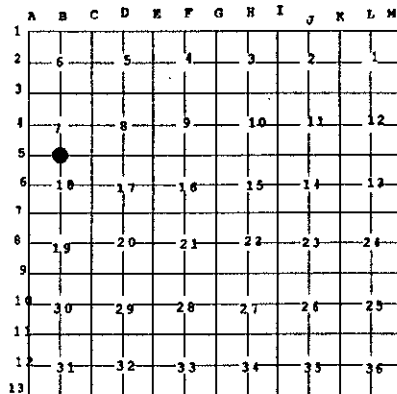

NOTE: Not more than 2 corners, all in the same town and range, may be recorded on this certificate.

A. Description of original monument and accessories and/or subsequent restoration:

- 1840: GLO Survey by Thos Pattison Set ¼ section post. Referenced: Tamarack 10-N16°W-15/No other.
- 1977: Survey by David B. Guthrie Existing Nail. Referenced: Power Pole-N45°E-59.10'/5" Ash-S75°E-89.30' 6" Poplar-S05°E-34.60'
- 1995: Survey by Earl T. Lewis Existing PK nail. Referenced: N35°E-58.74'-Power Pole/N70°W-159.73'-Power Pole/S25°E-34.46'-14" Aspen/ S45°W-52.23'-6" Aspen

B. Description of corner evidence found and/or method applied in restoring or reestablishing corner:

Found nail and tag centerline road E & W + N. Also found pk 0.72' East of nail and tag.
This corner position is compatible with county & local surveys. This corner position is accepted as a careful and faithful perpetuation of the position of the original corner.

C. Description of monument for corner and accessories established to perpetuate locating the position of the corner:

2000: Placed 3" Alcona County cap stamped to identify the corner over 1/2" iron rod in monument box.
Referenced:

- Found tag PS #27452 15" poplar-S8°E-34.56'
- Set tag in 10" poplar-S18°W-36.98'
- Center of GTE Box-N65°W-108.50'
- Found PK set tag in power pole-N44°E-59.21
- Found tag #27452 in 15" poplar-S15°E-34.38'
- Set tag in 10" ash S75°E-89.30'
- Found PK East 0.72'

APPROVED LAND CORNER
P A 345 of 1990
ALCONA COUNTY
Date 9-6-2000
County Rep. D.T. Kibbe



Signed by Daniel T. Kibbe
Surveyor's Michigan License No. 37278

Date September 15, 2000