

**2000 Alcona County Remonumentation Corner
LAND CORNER RECORDATION CERTIFICATE**
Filing Requirement of Act 74, Mich. P.A. 1970

For corners in

<u>Alcona</u> (County)	Located In:	Corner Code #
1. Public Land Survey	T <u>28N</u> R <u>8E</u>	<u>C-4</u> ✓
	T _____ R _____	_____
	T _____ R _____	_____
	T _____ R _____	_____
2. Property Controlling in Section	S _____ T _____ R _____	_____
	S _____ T _____ R _____	_____
3. Miscellaneous Property in Sec.	S _____ T _____ R _____	_____
	S _____ T _____ R _____	_____

Alcona County
Remonumentation
Liber 2 Page 58

Filed for Record in
ALCONA COUNTY MICHIGAN
DORIS A GAUTHIER
On 09-20-2000 At 09:36 am.
LAND CORNER 9.00

Register of Deeds Stamp & File
Number

4. Lot No. _____, Recorded Plat _____
5. Private Claims _____

I, Daniel T. Kibbe, in a field survey on April 7, 2000 do hereby state that under requirements of P.A. 74, Michigan P.A. of 1970, the corner points mentioned in lines 1 and 2 above were in conformance with regulations and rules therefore as required in the current manual of survey instructions of the United States Department of the Interior, Bureau of Land Management or by a decree of a Court of Law and /or that the corner points mentioned in lines 3, 4 and 5 above were in conformance with the rules of the Michigan Board of Land Surveyors or by a Decree of a Court of Law; established, re-established, monumented, recovered, found as expressed below:

	A	B	C	D	E	F	G	H	I	J	K	L	M
1													
2	6		5		4		3		2		1		
3													
4	7	●	8		9		10		11		12		
5													
6	18		17		16		15		14		13		
7													
8	19		20		21		22		23		24		
9													
10	30		29		28		27		26		25		
11													
12	31		32		33		34		35		36		
13													

NOTE: Not more than 2 corners, all in the same town and range, may be recorded on this certificate.

A. Description of original monument and accessories and/or subsequent restoration:

1840: GLO Survey by Thos. Pattison Set ¼ Sec. Post
Referenced: Hemlock 8-S50°E-25'/Maple 12-N60°W-20'
1903: County Survey by Edw. Chapelle NWT's set
Referenced: S. Maple 14-S56°W-42'/W. Pine Stump 36-N29°W-42'
1995: Survey by Earl T. Lewis Set ½" rebar (1/2"x6") centerline of road.
Referenced: N45°E-27.79'-5" Maple/S23°E-45.63'-6" Maple/S35°W-32.43'-5" Maple/West 96.66'-6" Balsam

B. Description of corner evidence found and/or method applied in restoring or reestablishing corner:

Found ½" rebar bent at top, straightened. Centerline road N & S, centerline fence E & W.

This corner position is compatible with county & local surveys. This corner position is accepted as a careful and faithful perpetuation of the position of the original corner.


C. Description of monument for corner and accessories established to perpetuate locating the position of the corner:

2000: Placed 3" Alcona County cap stamped to identify the corner over 1/2" iron rod 6" below grade.

Referenced:
Found tag #27452 in 7" maple-N64°E-27.80'
Found tag #27452 in 6" maple clump-S48°W-32.26'
Set tag in fence post-N40°W-41.64'
Set tag in 7" poplar-N39°E-77.42'

APPROVED LAND CORNER
P A 345 of 1990
ALCONA COUNTY
Date 9-6-2000
County Rep. D.T.K.

Signed by [Signature]
Surveyor's Michigan License No. 37278

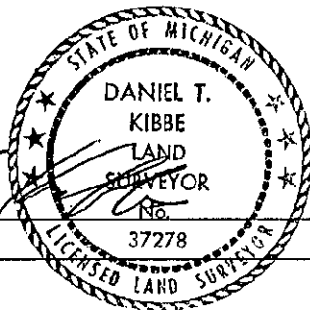

Date September 15, 2000

PROFESSIONAL SURVEYORS, JAN. 28, 1971

REVISED MAY 14, 1975

FORM APPROVED BY MICHIGAN STATE BOARD OF

REVISED JAN., 1983
REVISED OCT., 1995

**SURVEY &
REMONUMENTATION**

FEB 07 2001

SECTION