## SURVEY & REMONUMENTATION

1994 Alcona County Remonumentation Corner

APR 2 5 1995

## LAND CORNER RECORDATION CERTIFICATE Filing Requirement of Act 74, Mich. P.A. 1970

Nov	7	2	09	PH	194

RECORDED

EST SOURCE COMMISSI
---------------------

3. Miscellaneous

Property in Sec.

<u>.</u>	Alcona (County)	Located In:	Corner Code <i>≠</i> ≠
	Public Land Survey	T 28N R 8E	F-3
		T R T R	
.	Property Controlling	TR S T R	
	in Section	S T B	


\_ T ..... R \_


Alcona County Remonumentation Liber\_

Page G. T.L.

Register of Deeds Stamp & File Number

4.	Lot No	, Recorded Plat	
5	Privata Claims		

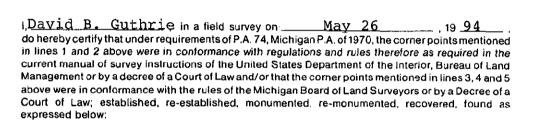

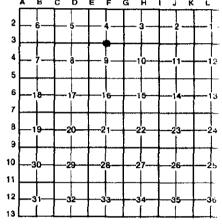

NOTE: Not more than 4 corners, all in the same town and range, may be recorded on this certificate.

- Description of original monument and accessories and/or subsequent restoration:
  - Survey by Thos. Pattison Set post and referenced Cedar 12 S50E 27 / Hemlock 10 N54W 20
  - 1978: Survey by D.R. MacNeill and Associates - Set 1" Iron Pipe
  - 1983: Survey by Ronald Bischer - Found 1" Iron Pipe
  - 1993: Survey by Thomas Fabis - Found 1" Iron Pipe
- B. Description of corner evidence found and/or method applied in restoring or reestablishing corner:
  - 1994: Found 1" Iron Pipe

- C. Description of monument for corner and accessories established to perpetuate locating the position of the corner:
  - Replaced with 5/8" Iron Rod with a 3" Brass Cap stamped to 1994: identify the corner placed in a Monument Box. E OF MICHIC Referenced

S16°W - 15" W. Pine - 74.11 feet S20°E - 24" Spruce - 54.32 feet N21°E - Utility Pole - 29.38 feet N26°W - 6" Elm - 29.38 feet

un SUCVE

Signed by	Put	R.	Cutur	Date New 5 19	94
oignou by					