

SURVEY & REMONUMENTATION

1994 APR 25 1995 Alcona County Remonumentation Corner

Alcona County
Remonumentation
Liber 1 Page 81

COMMISSION

LAND CORNER RECORDATION CERTIFICATE
Filing Requirement of Act 74, Mich. P.A. 1970

RECORDED

For corners in

<u>Alcona</u> <small>(County)</small>	Located In:	Corner Code #	
1. Public Land Survey	T <u>28N</u> R <u>8E</u>	<u>G-3</u>	
	T _____ R _____	_____	
	T _____ R _____	_____	
	T _____ R _____	_____	
2. Property Controlling in Section	S _____ T _____ R _____	_____	
	S _____ T _____ R _____	_____	
3. Miscellaneous Property in Sec.	S _____ T _____ R _____	_____	
	S _____ T _____ R _____	_____	
4. Lot No. _____, Recorded Plat _____			
5. Private Claims _____			

DEC 9 10 32 AM '94

David A. Guthrie
REGISTER OF DEEDS
ALCONA COUNTY MICHIGAN


Register of Deeds Stamp & File Number

I, David B. Guthrie in a field survey on May 26, 1994, do hereby certify that under requirements of P.A. 74, Michigan P.A. of 1970, the corner points mentioned in lines 1 and 2 above were in conformance with regulations and rules therefore as required in the current manual of survey instructions of the United States Department of the Interior, Bureau of Land Management or by a decree of a Court of Law and/or that the corner points mentioned in lines 3, 4 and 5 above were in conformance with the rules of the Michigan Board of Land Surveyors or by a Decree of a Court of Law; established, re-established, monumented, re-monumented, recovered, found as expressed below:

	A	B	C	D	E	F	G	H	I	J	K	L
2	6		5		4		3		2		1	
3												
4	7		8		9		10		11		12	
5												
6	18		17		16		15		14		13	
7												
8	19		20		21		22		23		24	
9												
10	30		29		28		27		26		25	
11												
12	31		32		33		34		35		36	
13												

NOTE: Not more than 4 corners, all in the same town and range, may be recorded on this certificate.

- A. Description of original monument and accessories and/or subsequent restoration:
- 1840: G.L.O. Survey by Thos. Pattison - Set post and referenced Hemlock 18 - N40W - 20 / Maple 18 - S65E - 20
 - 1972: Survey by James L. Scott
 - 1978: Survey by D.R. MacNeill and Associates - Found 1½" Iron Pipe
 - 1983: Survey by Ronald Bischer - Found 1½" Iron Pipe
- B. Description of corner evidence found and/or method applied in restoring or reestablishing corner:
- 1994: Found 1½" Iron Pipe at the intersection of Spruce and Gillard Roads.
- C. Description of monument for corner and accessories established to perpetuate locating the position of the corner:
- 1994: Replaced with 5/8" Iron Rod with a 3" Brass Cap stamped to identify the corner placed in a Monument Box.
Referenced -
 - S45°W - Anchor Pole - 48.15 feet
 - S22°W - Utility Pole - 67.10 feet
 - N41°E - Utility Pole - 77.77 feet
 - N29°W - Utility Pole - 33.05 feet

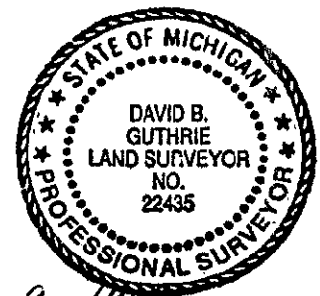

Signed by David B. Guthrie Date Dec. 9, 1994
Surveyor's Michigan License No. 22435