2000 Alcona County Remonumentation Corner
LAND CORNER RECORDATION CERTIFICATE
Filing Requirement of Act 74, Mich. P.A. 1970

For corners in

Alcona (County)

	Located In:	Corner Code #
1. Public Land Survey	T 28N R8E	I-4 ✓
	T___ R___	
	T___ R___	
	T___ R___	
2. Property Controlling	S___ T___ R___	
in Section	S___ T___ R___	
3. Miscellaneous	S___ T___ R___	
Property in Sec.	S___ T___ R___	

Alcona County
Remonumentation
Liber 2 Page 50

0
Filed for Record in
ALCONA COUNTY MICHIGAN
DORIS A GAUTHIER
On 09-20-2000 At 09:36 am.
LAND CORNER 9.00

Register of Deeds Stamp & File Number

4. Lot No. _____, Recorded Plat _____
5. Private Claims _____

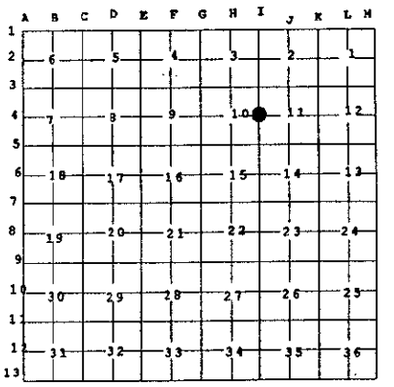

I, Daniel T. Kibbe, in a field survey on June 8, 2000 do hereby state that under requirements of P.A. 74, Michigan P.A. of 1970, the corner points mentioned in lines 1 and 2 above were in conformance with regulations and rules therefore as required in the current manual of survey instructions of the United States Department of the Interior, Bureau of Land Management or by a decree of a Court of Law and /or that the corner points mentioned in lines 3, 4 and 5 above were in conformance with the rules of the Michigan Board of Land Surveyors or by a Decree of a Court of Law; established, re-established, monumented, recovered, found as expressed below:

NOTE: Not more than 2 corners, all in the same town and range, may be recorded on this certificate.

A. Description of original monument and accessories and/or subsequent restoration:

1840:	GLO Survey by Louis Cleason	Set ¼ corner Referenced: Cedar 18-S70°W-12/Cedar 20-N65°E-20
1978:	Survey by David B. Guthrie	Existing 1" pipe. Referenced: Power Pole-West-24.15'/Fence Corner-East-30.15'/4" Poplar-S45°E-31.55'
1978:	L.C.R.C. by David B. Guthrie Liber 1, page 69	Existing 1" iron pipe set by others. Referenced: West power pole-24.15'/East fence corner-30.15'/S45°E-4" Poplar-31.55'
1997:	Survey by Daniel T. Kibbe	Referenced Liber 1, page 69

B. Description of corner evidence found and/or method applied in restoring or reestablishing corner:

Found 1" pipe 4" below grade in centerline of Hansen Rd. on fence line West.

This corner position is compatible with county & local surveys. This corner position is accepted as a careful and faithful perpetuation of the position of the original corner.

C. Description of monument for corner and accessories established to perpetuate locating the position of the corner:

2000: Placed 3" Alcona County cap stamped to identify the corner over 1/2" iron rod 6" below grade.
Referenced:
Set tag in 4" poplar tree-S60°E-28.33'
Found tag in power pole-N89°W-24.26'
Set tag in corner post-N85°W-26.62'
Set tag in power pole-N80°W-29.80'

APPROVED LAND CORNER
P A 345 of 1990
ALCONA COUNTY
Date 9-6-2000
County Rep. [illegible]

STATE OF MICHIGAN
DANIEL T. KIBBE
LAND SURVEYOR
No. 37278
LICENSED LAND SURVEYOR

Signed by [signature]

Date September 15, 2000

Surveyor's Michigan License No. 37278

FORM APPROVED BY MICHIGAN STATE BOARD OF PROFESSIONAL SURVEYORS, JAN. 28, 1971

REVISED MAY 14,1975

REVISED JAN., 1983
REVISED OCT., 1995

SURVEY & REMONUMENTATION

FEB 07 2001

SECTION