

1996 Alcona County Remonumentation

LAND CORNER RECORDATION CERTIFICATE
Filing Requirement of Act 74, Mich. P.A. 1970

Alcona County
 Remonumentation

For corners in
Alcona
(County)

Located In:

Corner Code #

Liber 1 Page 215
 RECORDED

- | | | | | | |
|--------------------------------------|---|------------|---|-----------|------------|
| 1. Public Land Survey | T | <u>28N</u> | R | <u>8E</u> | <u>M-5</u> |
| | T | <u>28N</u> | R | <u>9E</u> | <u>A-5</u> |
| | T | _____ | R | _____ | _____ |
| | T | _____ | R | _____ | _____ |
| 2. Property Controlling in Section | S | _____ | T | _____ | _____ |
| | S | _____ | T | _____ | _____ |
| 3. Miscellaneous Property in Section | S | _____ | T | _____ | _____ |
| | S | _____ | T | _____ | _____ |

APPROVED LAND CORNER

P A 345 of 1990

ALCONA COUNTY

Date 11-21-96

County Rep. [Signature]

Nov 21 1 50 PM '96

[Signature]
 REGISTER OF DEEDS
 ALCONA COUNTY, MICHIGAN

Register of Deeds Stamp & File Number

4. Lot No. _____, Recorded Plat _____
5. Private Claims _____

	A	B	C	D	E	F	G	H	I	J	K	L	M
2	6		5		4		3		2		1		
3													
4	7		8		9		10		11		12		
5													
6	18		17		16		15		14		13		
7													
8	19		20		21		22		23		24		
9													
10	30		29		28		27		26		25		
11													
12	31		32		33		34		35		36		
13													

I, Daniel T. Kibbe, in a field survey on June 20, 1996
do hereby certify that under requirements of P.A. 74, Michigan P.A. of 1970, the corner points mentioned in lines 1 and 2 above were in conformance with regulations and rules therefore as required in the current manual of survey instructions of the United States Department of the Interior, Bureau of Land Management or by a decree of a Court of Law and/or that the corner points mentioned in lines 3, 4 and 5 above were in conformance with the rules of the Michigan Board of Professional Surveyors or by a Decree of a Court of Law; established, re-established, monumented, re-monumented, recovered, found as expressed below:

NOTE: Not more than 4 corners, all in the same town and range, may be recorded on this certificate.

A. Description of original monument and accessories and/or subsequent restoration:

- 1839: G.L.O. Survey by Lewis Clason - set post & referenced: Beech 14 - S 50 W - 35 / Hemlock 14 - N 18 1/2 W - 31.
- 1840: G.L.O. Survey - post.
- 1905: County Survey by Edward Chapelle Sr. - post.
- 1982: Survey by Duane MacNeill - found P.K. nail & referenced.
- 1994: MDOT F-41 Alignment by Cliff Lindgren - 60-D penny nail, referenced.

B. Description of corner evidence found and/or method applied in restoring or reestablishing corner:

1996: Found nail in C/L F-41, 0.3' below surface.


This corner position is compatible with county and local surveys and agrees with MDOT records. This corner position is accepted as a careful and faithful perpetuation of the position of the original corner.

C. Description of monument for corner and accessories established to perpetuate locating the position of the corner:

1996: Placed 3" Alcona County cap stamped to identify the corner over 1/2" iron rod in monument box.

Referenced:

- S 58° E - 67.98' - fd. MDOT Tag in 19" Red Pine
- N 48° E - 85.68' - set N/Tag in 8" Red Pine
- N 38° W - 60.95' - center of Swede Rd. sign
- S 61° W - 118.90' - fd. MDOT Tag in 10" Red Pine

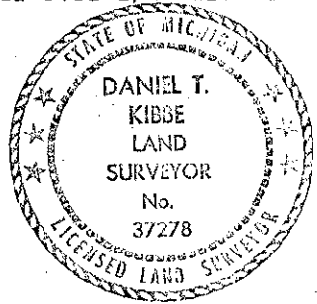

Signed by [Signature] Date October 16, 1996

Surveyor's Michigan License No. 37278

FORM APPROVED BY MICHIGAN STATE BOARD OF PROFESSIONAL SURVEYORS, JAN. 28, 1971
 REVISED MAY 14, 1975
 REVISED JAN, 1983

SURVEY & REMONUMENTATION

DEC 1 6 1996
 COMMISSION