

LAND CORNER RECORDATION CERTIFICATE
Filing Requirement of Act 74, Mich. P.A. 1970

Alcona County
 Remonumentation
 Liber 7 Page 216
RECORDED

For corners in Alcona Located In: _____ Corner Code # _____
 (County)

1. Public Land Survey	T	<u>28N</u>	R	<u>8E</u>	<u>M-6</u>
	T	<u>28N</u>	R	<u>9E</u>	<u>A-6</u>
	T	_____	R	_____	_____
	T	_____	R	_____	_____
2. Property Controlling in Section	S	_____	T	_____	_____
	S	_____	T	_____	_____
3. Miscellaneous Property in Section	S	_____	T	_____	_____
	S	_____	T	_____	_____

APPROVED LAND CORNER
 P.A. 345 of 1990
 ALCONA COUNTY
 Date 11-21-96
 Register of Deeds Stamp & File Number

Nov 21 1 50 PM '96

Doris A. [Signature]
 REGISTER OF DEEDS
 ALCONA COUNTY, MICHIGAN

4. Lot No. _____, Recorded Plat _____
 5. Private Claims _____

	A	B	C	D	E	F	G	H	I	J	K	L	M
2	6		5		4		3		2		1		
3													
4	7		8		9		10		11		12		
5													
6	18		17		16		15		14		13		
7													
8	19		20		21		22		23		24		
9													
10	30		29		28		27		26		25		
11													
12	31		32		33		34		35		36		
13													


I, Daniel T. Kibbe, in a field survey on June 20, 19 96, do hereby certify that under requirements of P.A. 74, Michigan P.A. of 1970, the corner points mentioned in lines 1 and 2 above were in conformance with regulations and rules therefore as required in the current manual of survey instructions of the United States Department of the Interior, Bureau of Land Management or by a decree of a Court of Law and/or that the corner points mentioned in lines 3, 4 and 5 above were in conformance with the rules of the Michigan Board of Professional Surveyors or by a Decree of a Court of Law; established, re-established, monumented, re-monumented, recovered, found as expressed below:

NOTE: Not more than 4 corners, all in the same town and range, may be recorded on this certificate.

- A. Description of original monument and accessories and/or subsequent restoration:**
 1839: G.L.O. Survey by Lewis Clason - set post & referenced: Hemlock 12 - S 23 W - 14 / Hemlock 12 - N 58 W - 36.
 1994: MDOT F-41 Alignment by Cliff Lindgren - nail & brass tag, referenced.
 1995: Surveys by Earl Lewis - existing buried iron, raised with nail, referenced.

- B. Description of corner evidence found and/or method applied in restoring or reestablishing corner:**
 1996: Found nail with tag in C/L F-41.
 This corner position is compatible with local surveys and agrees with MDOT records. This corner position is accepted as a careful and faithful perpetuation of the position of the original corner.

- C. Description of monument for corner and accessories established to perpetuate locating the position of the corner:**
 1996: Placed 3" Alcona County cap stamped to identify the corner over 1/2" iron rod in monument box.
 Referenced:
 East - 41.40' - fd. MDOT Tag in fence post
 West - 100.50' - fd. MDOT Tag in fence post
 N 42° E - 75.32' - fd. MDOT Tag in fence post
 S 67° W - 78.36' - set N/Tag in 18" Red Pine

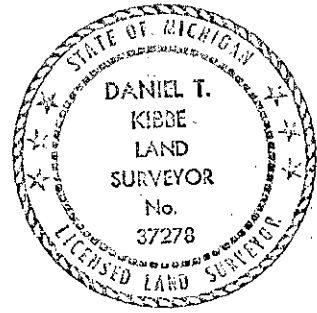

Signed by [Signature] Date October 16, 1996
 Surveyor's Michigan License No. 37278

REMONUMENTATION
 DEC 16 1996
 COMMISSION