

1996 Alcona County Remonumentation

LAND CORNER RECORDATION CERTIFICATE
Filing Requirement of Act 74, Mich. P.A. 1970

Alcona County
 Remonumentation
 Liber 1 Page 220
 RECORDED

For corners in Alcona Located In: Corner Code #
 (County)

- | | | | | |
|--------------------------------------|---|------------|---|-----------|
| 1. Public Land Survey | T | <u>28N</u> | R | <u>8E</u> |
| | T | <u>28N</u> | R | <u>9E</u> |
| | T | | R | |
| | T | | R | |
| 2. Property Controlling in Section | S | | T | R |
| | S | | T | R |
| 3. Miscellaneous Property in Section | S | | T | R |
| | S | | T | R |

M-11
 A-11

APPROVED LAND CORNER
 P. A. 345 OF 1990
 ALCONA COUNTY
 Date: 11-21-96
 County Rep S. J. J.

Nov 21 1 51 PM '96

Daniel A. Boudier
 REGISTER OF DEEDS
 ALCONA COUNTY MICHIGAN

Register of Deeds Stamp & File Number

4. Lot No. _____, Recorded Plat _____
 5. Private Claims _____

	A	B	C	D	E	F	G	H	I	J	K	L	M
2	6		5		4		3		2		1		
3													
4	7		8		9		10		11		12		
5													
6	18		17		16		15		14		13		
7													
8	19		20		21		22		23		24		
9													
10	30		29		28		27		26		25		
11													
12	31		32		33		34		35		36		
13													

I, Daniel T. Kibbe, in a field survey on June 20, 1996, do hereby certify that under requirements of P.A. 74, Michigan P.A. of 1970, the corner points mentioned in lines 1 and 2 above were in conformance with regulations and rules therefore as required in the current manual of survey instructions of the United States Department of the Interior, Bureau of Land Management or by a decree of a Court of Law and/or that the corner points mentioned in lines 3, 4 and 5 above were in conformance with the rules of the Michigan Board of Professional Surveyors or by a Decree of a Court of Law; established, re-established, monumented, re-monumented, recovered, found as expressed below:

NOTE: Not more than 4 corners, all in the same town and range, may be recorded on this certificate.

A. Description of original monument and accessories and/or subsequent restoration:


- 1839: G.L.O. Survey by Lewis Clason - set post & referenced: Y. Pine 20 - S 29 1/2 W - 35 / Hemlock 14 - N 47 W - 33.
- 1840: G.L.O. Survey - post.
- 1907: Edward Chapelle - N.B.T.
- 1913: County Survey by Andrew Freer - gas pipe 49" long, 1 1/2" in diameter, referenced.
- 1994: MDOT F-41 Alignment by Cliff Lindgren - 1 1/2" iron pipe raised with P.K. nail, referenced.

B. Description of corner evidence found and/or method applied in restoring or reestablishing corner:

1996: Found 1/2" rebar flush with ground, 0.5' West of C/L F-41.
 This corner position is compatible with county surveys and agrees with MDOT records. This corner position is accepted as a careful and faithful perpetuation of the position of the original corner.

C. Description of monument for corner and accessories established to perpetuate locating the position of the corner:

1996: Placed 3" Alcona County cap stamped to identify the corner over 1/2" iron rod in monument box.
 Referenced:
 N 42° W - 60.15' - fd. MDOT N/Tag in 18" S. Pine
 S 47° W - 66.25' - fd. MDOT N/Tag in 19" S. Pine
 N 73° E - 76.30' - set N/Tag in 10" Birch
 S 74° E - 76.92' - set N/Tag in 14" Balsam

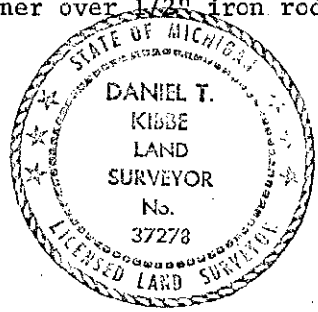

Signed by *Daniel T. Kibbe*

Date October 16, 1996

Surveyor's Michigan License No. 37278

FORM APPROVED BY MICHIGAN STATE BOARD OF PROFESSIONAL SURVEYORS, JAN. 28, 1971
 REVISED MAY 14, 1975
 REVISED JAN., 1983

SURVEY &
 REMONUMENTATION

DEC 1 6 1996
 COMMISSION