1996 Alcona County Remonumentation

Alcona County
Remonumentation
Liber 1 Page 209
RECORDED

LAND CORNER RECORDATION CERTIFICATE

Filing Requirement of Act 74, Mich. P.A. 1970

For corners in Alcona (County)

	Located In:	Corner Code #
1. Public Land Survey	T 28N R 8E	M-12
	T 28N R 9E	A-12
	T ___ R ___	
	T ___ R ___	
2. Property Controlling	S ___ T ___ R ___	
in Section	S ___ T ___ R ___	
3. Miscellaneous	S ___ T ___ R ___	
Property in Section	S ___ T ___ R ___	

APPROVED LAND CORNER
E.T.L. 1990
ALCONA COUNTY
Date
County Rep

Nov 21 1 49 PM

Dana A Smith
REGISTER OF DEEDS
ALCONA COUNTY MICHIGAN

Register of Deeds Stamp & File Number

4. Lot No. _____, Recorded Plat _____
5. Private Claims _____

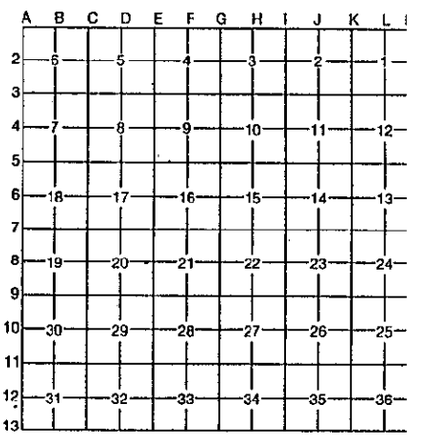

I, Daniel T. Kibbe, in a field survey on October 16, 19 96, do hereby certify that under requirements of P.A. 74, Michigan P.A. of 1970, the corner points mentioned in lines 1 and 2 above were in conformance with regulations and rules therefore as required in the current manual of survey instructions of the United States Department of the Interior, Bureau of Land Management or by a decree of a Court of Law and/or that the corner points mentioned in lines 3, 4 and 5 above were in conformance with the rules of the Michigan Board of Professional Surveyors or by a Decree of a Court of Law; established, re-established, monumented, re-monumented, recovered, found as expressed below:

NOTE: Not more than 4 corners, all in the same town and range, may be recorded on this certificate.

A. Description of original monument and accessories and/or subsequent restoration:

1839: G.L.O. Survey by Lewis Clason - set post & referenced: W. Pine 13 - S 45 1/2 W - 25 / Y. Pine 20 - N 36 1/2 W - 24.
1913: County Survey by Andrew Freer - Piece of slay shoe 36" long, 3" wide, referenced.

B. Description of corner evidence found and/or method applied in restoring or reestablishing corner:

1996: No monumentation found. Corner position established by single proportionate method.

SURVEY &
REMONUMENTATION
JUN 29 2000
SECTION

C. Description of monument for corner and accessories established to perpetuate locating the position of the corner:

1996: Placed 3" Alcona County cap stamped to identify the corner over 1/2" iron rod in monument box.
Referenced:
S 48° W - 60.84' - set N/Tag in Power Pole
N 85° W - 58.35' - set N/Tag in 20" Poplar
N 45° W - 82.52' - set N/Tag in 10" Birch
S 84° E - 60.52' - set N/Tag in 7" Birch

STATE OF MICHIGAN
DANIEL T. KIBBE
LAND SURVEYOR
No. 37278
LICENSED LAND SURVEYOR

Signed by [signature] Date October 16, 1996

Surveyor's Michigan License No. 37278

FORM APPROVED BY MICHIGAN STATE BOARD OF PROFESSIONAL SURVEYORS, JAN. 28, 1971
REVISED MAY 14, 1975
REVISED JAN., 1983