

LAND CORNER RECORDATION CERTIFICATE
 Filing Requirement of Act 74, Mich. P.A. 1970

Alcona County
 Remonumentation
 Liber 1 Page 214

For corners in Alcona (County)	Located In:	Corner Code #
1. Public Land Survey	T 28N R 8E T 28N R 9E T _____ R _____ T _____ R _____	M-4 <u>A-4</u>
2. Property Controlling in Section	S _____ T _____ R _____ S _____ T _____ R _____	
3. Miscellaneous Property in Section	S _____ T _____ R _____ S _____ T _____ R _____	

APPROVED LAND CORNER
 P.A. 345 of 1990
 ALCONA COUNTY
 Date 11-21-96
 County Rep ETL

RECORDED
 Nov 21 1 50 PM '96
Dani A. Buntline
 REGISTER OF DEEDS
 ALCONA COUNTY MICHIGAN

Register of Deeds Stamp & File Number

4. Lot No. _____, Recorded Plat _____
 5. Private Claims _____

	A	B	C	D	E	F	G	H	I	J	K	L	M
2	6	5	4	3	2								
3													
4	7	8	9	10	11	12							
5													
6	18	17	16	15	14	13							
7													
8	19	20	21	22	23	24							
9													
10	30	29	28	27	26	25							
11													
12	31	32	33	34	35	36							
13													

I, Daniel T. Kibbe, in a field survey on June 20, 19 96, do hereby certify that under requirements of P.A. 74, Michigan P.A. of 1970, the corner points mentioned in lines 1 and 2 above were in conformance with regulations and rules therefore as required in the current manual of survey instructions of the United States Department of the Interior, Bureau of Land Management or by a decree of a Court of Law and/or that the corner points mentioned in lines 3, 4 and 5 above were in conformance with the rules of the Michigan Board of Professional Surveyors or by a Decree of a Court of Law; established, re-established, monumented, re-monumented, recovered, found as expressed below:

NOTE: Not more than 4 corners, all in the same town and range, may be recorded on this certificate.

A. Description of original monument and accessories and/or subsequent restoration:

- 1839: G.L.O. Survey by Lewis Clason - set post & referenced: Hemlock 24 - S 21 W - 52 / Hemlock 22 - N 51 W - 19.
- 1977: Survey by Duane MacNeill - set P.K. and cap by single proportion & referenced.
- 1982: Survey by Duane MacNeill - set P.K. & referenced.
- 1982: Survey by Duane MacNeill
- 1988: Survey by Duane MacNeill
- 1994: MDOT F-41 Alignment by Cliff Lindgren - rerod & LLS cap, referenced.

B. Description of corner evidence found and/or method applied in restoring or reestablishing corner:

1996: Found bar & cap #22435 in C/L F-41.

This corner position is compatible with local surveys and agrees with MDOT records. This corner position is accepted as a careful and faithful perpetuation of the position of the original corner.

SURVEY & REMONUMENTATION


DEC 16 1996

COMMISSION

C. Description of monument for corner and accessories established to perpetuate locating the position of the corner:

1996: Placed 3" Alcona County cap stamped to identify the corner over 1/2" iron rod in monument box.

- Referenced:
- N 58° W - 66.05' - set N/Tag in 20" White Pine
 - S 85° W - 61.45' - set N/Tag in 18" Red Pine
 - S 63° E - 87.15' - set N/Tag in 14" Twin Red Pine
 - N 70° E - 73.09' - set N/Tag in 16" Maple

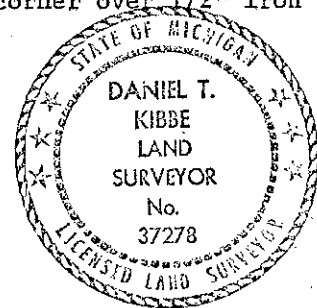

Signed by *Daniel T. Kibbe*

Date October 16, 1996

Surveyor's Michigan License No. 37278