

**LAND CORNER RECORDATION CERTIFICATE**  
**Filing Requirement of Act 74, Mich. P.A. 1970**

Alcona County  
 Remonumentation  
 Liber 1 Page 215  
**RECORDED**

For corners in  
Alcona  
 (County)

Located In:

Corner Code #

- |                                    |                          |            |
|------------------------------------|--------------------------|------------|
| 1. Public Land Survey              | T <u>28N</u> R <u>8E</u> | M-5        |
|                                    | T <u>28N</u> R <u>9E</u> | <u>A-5</u> |
|                                    | T _____ R _____          | _____      |
|                                    | T _____ R _____          | _____      |
| 2. Property Controlling in Section | S _____ T _____ R _____  | _____      |
|                                    | S _____ T _____ R _____  | _____      |
| 3. Miscellaneous                   | S _____ T _____ R _____  | _____      |
| Property in Section                | S _____ T _____ R _____  | _____      |

APPROVED LAND CORNER  
 P A 345 of 1990  
 ALCONA COUNTY

Date 11-21-96  
 County Rep. 51122

Nov 21 1 50 PM '96

*Dennis A. Gaudin*  
 REGISTER OF DEEDS  
 ALCONA COUNTY MICHIGAN

Register of Deeds Stamp & File Number

4. Lot No. \_\_\_\_\_, Recorded Plat \_\_\_\_\_  
 5. Private Claims \_\_\_\_\_

| A  | B  | C | D  | E | F  | G | H  | I | J  | K | L  | M |
|----|----|---|----|---|----|---|----|---|----|---|----|---|
| 2  | 6  |   | 5  |   | 4  |   | 3  |   | 2  |   | 1  |   |
| 3  |    |   |    |   |    |   |    |   |    |   |    |   |
| 4  | 7  |   | 8  |   | 9  |   | 10 |   | 11 |   | 12 |   |
| 5  |    |   |    |   |    |   |    |   |    |   |    |   |
| 6  | 18 |   | 17 |   | 16 |   | 15 |   | 14 |   | 13 |   |
| 7  |    |   |    |   |    |   |    |   |    |   |    |   |
| 8  | 19 |   | 20 |   | 21 |   | 22 |   | 23 |   | 24 |   |
| 9  |    |   |    |   |    |   |    |   |    |   |    |   |
| 10 | 30 |   | 29 |   | 28 |   | 27 |   | 26 |   | 25 |   |
| 11 |    |   |    |   |    |   |    |   |    |   |    |   |
| 12 | 31 |   | 32 |   | 33 |   | 34 |   | 35 |   | 36 |   |
| 13 |    |   |    |   |    |   |    |   |    |   |    |   |

I, Daniel T. Kibbe, in a field survey on June 20, 19 96, do hereby certify that under requirements of P.A. 74, Michigan P.A. of 1970, the corner points mentioned in lines 1 and 2 above were in conformance with regulations and rules therefore as required in the current manual of survey instructions of the United States Department of the Interior, Bureau of Land Management or by a decree of a Court of Law and/or that the corner points mentioned in lines 3, 4 and 5 above were in conformance with the rules of the Michigan Board of Professional Surveyors or by a Decree of a Court of Law; established, re-established, monumented, re-monumented, recovered, found as expressed below:

**NOTE: Not more than 4 corners, all in the same town and range, may be recorded on this certificate.**

**A. Description of original monument and accessories and/or subsequent restoration:**

- 1839: G.L.O. Survey by Lewis Clason - set post & referenced: Beech 14 - S 50 W - 35 / Hemlock 14 - N 18 1/2 W - 31.
- 1840: G.L.O. Survey - post.
- 1905: County Survey by Edward Chapelle Sr. - post.
- 1982: Survey by Duane MacNeill - found P.K. nail & referenced.
- 1994: MDOT F-41 Alignment by Cliff Lindgren - 60-D penny nail, referenced.

**B. Description of corner evidence found and/or method applied in restoring or reestablishing corner:**

1996: Found nail in C/L F-41, 0.3' below surface.

This corner position is compatible with county and local surveys and agrees with MDOT records. This corner position is accepted as a careful and faithful perpetuation of the position of the original corner.

**SURVEY & REMONUMENTATION**

DEC 16 1996


COMMISSION

**C. Description of monument for corner and accessories established to perpetuate locating the position of the corner:**

1996: Placed 3" Alcona County cap stamped to identify the corner over 1/2" iron rod in monument box.

Referenced:

- S 58° E - 67.98' - fd. MDOT Tag in 19" Red Pine
- N 48° E - 85.68' - set N/Tag in 8" Red Pine
- N 38° W - 60.95' - center of Swede Rd. sign
- S 61° W - 118.90' - fd. MDOT Tag in 10" Red Pine

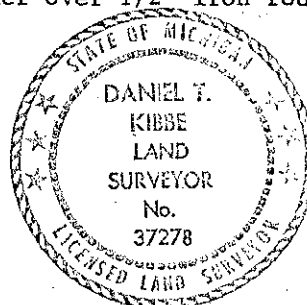

Signed by *Daniel T. Kibbe*

Date October 16, 1996

Surveyor's Michigan License No. 37278