

1996 Alcona County Remonumentation

LAND CORNER RECORDATION CERTIFICATE
Filing Requirement of Act 74, Mich. P.A. 1970

Alcona County
 Remonumentation 218
 Liber 1 Page RECORDED

For corners in Alcona (County) Located In: Corner Code #

1. Public Land Survey	T <u>28N</u> R <u>8E</u>	M-9
	T <u>28N</u> R <u>9E</u>	<u>A-9</u>
	T _____ R _____	
	T _____ R _____	
2. Property Controlling in Section	S _____ T _____ R _____	
	S _____ T _____ R _____	
3. Miscellaneous Property in Section	S _____ T _____ R _____	
	S _____ T _____ R _____	

APPROVED LAND CORNER
 P. A. 345 of 1990
 ALCONA COUNTY
 Date: 11-21-96
 County Ref: 5-T-1

Nov 21 1 51 PM '96
Dana A. Guthrie
 REGISTER OF DEEDS
 ALCONA COUNTY, MICHIGAN
 Register of Deeds Stamp & File Number

4. Lot No. _____, Recorded Plat _____
 5. Private Claims _____

A	B	C	D	E	F	G	H	I	J	K	L	M
2	6	5	4	3	2	1						
3												
4	7	8	9	10	11	12						
5												
6	18	17	16	15	14	13						
7												
8	19	20	21	22	23	24						
9												
10	30	29	28	27	26	25						
11												
12	31	32	33	34	35	36						
13												

I, Daniel T. Kibbe, in a field survey on June 20, 1996 do hereby certify that under requirements of P.A. 74, Michigan P.A. of 1970, the corner points mentioned in lines 1 and 2 above were in conformance with regulations and rules therefore as required in the current manual of survey instructions of the United States Department of the Interior, Bureau of Land Management or by a decree of a Court of Law and/or that the corner points mentioned in lines 3, 4 and 5 above were in conformance with the rules of the Michigan Board of Professional Surveyors or by a Decree of a Court of Law; established, re-established, monumented, re-monumented, recovered, found as expressed below:

NOTE: Not more than 4 corners, all in the same town and range, may be recorded on this certificate.

A. Description of original monument and accessories and/or subsequent restoration:

- 1839: G.L.O. Survey by Lewis Clason - set post & referenced: W. Pine 26 - S 30 1/2 W - 12 / W. Pine 12 - N 44 W - 44.
- 1840: G.L.O. Survey - post.
- 1907: Edward Chapelle - N.B.T.
- 1913: County Survey by Andrew Freer - switch iron 48" long, 1 1/2" wide, referenced.
- 1983: Survey by Dave Guthrie - referenced existing iron rod.
- 1994: MDOT F-41 Alignment by Cliff Lindgren - referenced P.K. nail.

B. Description of corner evidence found and/or method applied in restoring or reestablishing corner:


1996: Found P.K. nail 0.6' South of C/L F-41.

This corner position is compatible with county and local surveys and agrees with MDOT records. This corner position is accepted as a careful and faithful perpetuation of the position of the original corner.

C. Description of monument for corner and accessories established to perpetuate locating the position of the corner:

1996: Placed 3" Alcona County cap stamped to identify the corner over 1/2" iron rod in monument box.

- Referenced:
- S 81° E - 64.55' - fd. MDOT N/Tag in Power Pole
 - S 46° W - 73.70' - fd. MDOT N/Tag in 14" White Pine
 - S 76° W - 49.48' - fd. MDOT N/Tag in 9" Jack Pine
 - N 37° W - 65.79' - fd. MDOT N/Tag in 10" White Pine

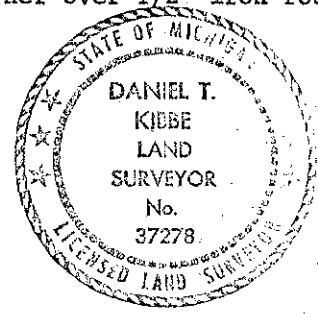

Signed by *Daniel T. Kibbe* Date October 16, 1996

Surveyor's Michigan License No. 37278
 SURVEY &
 REMONUMENTATION

DEC 16 1996

CONFIRMATION