

SURVEY & REMONUMENTATION

FEB 19 1999

1998 ALCONA COUNTY REMONUMENTATION CORNER

LAND CORNER RECORDATION CERTIFICATE
Filing Requirement of Act 74, Mich. P.A. 1970

For corners in **SECTION**

Alcona (County)	Located In:	Corner Code #
1. Public Land Survey	T28N R9E	C-7
	T R	Alcona Twp.
	T R	
	T R	
2. Property Controlling in Section	S T R	
	S T R	
3. Miscellaneous Property in Sec.	S T R	
	S T R	

Alcona County Remonumentation Liber 7 Page 320

0
Filed for Record in
ALCONA COUNTY MICHIGAN
DORIS A GAUTHIER
On 12-17-1998 At 05:34:41 pm.
LAND CORNER 9.00
OR


APPROVED LAND CORNER
P A 345 of 1990
ALCONA COUNTY
Date 10/21/98
County Rep D. B. Gault

Register of Deeds Stamp & File Number

4. Lot No. _____, Recorded Plat _____
5. Private Claims _____

I, Thomas L. Fabis, in a field survey on May 27, 19 98 do hereby state that under requirements of P.A. 74, Michigan P.A. of 1970, the corner points mentioned in lines 1 and 2 above were in conformance with regulations and rules therefore as required in the current manual of survey instructions of the United States Department of the Interior, Bureau of Land Management or by a decree of a Court of Law and /or that the corner points mentioned in lines 3, 4 and 5 above were in conformance with the rules of the Michigan Board of Land Surveyors or by a Decree of a Court of Law; established, re-established, monumented, recovered, found as expressed below:

NOTE: Not more than 2 corners, all in the same town and range, may be recorded on this certificate.

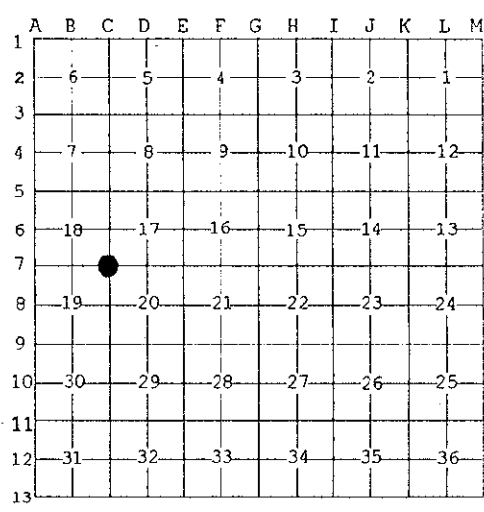

- A. Description of original monument and accessories and/or subsequent restoration:
- 1840: G.L.O. Survey Thos. Pattison Set post & referenced: Elm 5 S45W 4, Fir 6 N68E 36.
 - 1985: LCRC L. 1 P.200 & Survey L.200 P. 835 & 839 David Guthrie Set Forest Service Conc. Mon. 12" below road surface & nail directly above & referenced.
 - 1987: R.S.Scott Survey W.O.1-1473 David Guthrie Ex. Conc. Mon. & referenced.
 - 1998: Survey & Section Breakdown Notes John Oliver Found 60 Penny nail.

- B. Description of corner evidence found and/or method applied in restoring or reestablishing corner:
- 1998: Found 60 Penny nail over Forest Service Conc. Mon. in paved centerline of Black River Rd. 18' East of Sayers Rd. centerline to the North and 6' East of Sayers Rd. centerline to the South and also, found one existing witness: 60 Penny nail in Fe. Cor. Post N25E 47.38'.

The position of this corner is compatible with local and Forest Service surveys and is accepted as a careful and faithful perpetuation of the position of the original corner.

- C. Description of monument for corner and accessories established to perpetuate locating the position of the corner:
- 1998: Removed 60 Penny nail and set monument box around existing Forest Service Concrete Monument. Witnesses are:
 - Existing 60 Penny nail in Fe. Cor. Post N25E 47.38'
 - Set tag in Fe. Cor. Post S35E 41.83'
 - Set tag in 13" Twin Willows S26E 55.09'
 - Set tag in New Pole N45W 69.77'

Signed by Thomas L. Fabis Date December 11, 1998
Surveyor's Michigan License No. 31591

