

FEB 19 1999

1998 ALCONA COUNTY REMONUMENTATION CORNER

LAND CORNER RECORDATION CERTIFICATE
Filing Requirement of Act 74, Mich. P.A. 1970

SECTION
For corners in

<u>Alcona</u> (County)	Located In:	Corner Code #
1. Public Land Survey	T28N R 9E	D-7
	T R	Alcona Twp.
	T R	
	T R	
2. Property Controlling in Section	S T R	
	S T R	
3. Miscellaneous Property in Sec.	S T R	
	S T R	
4. Lot No. _____, Recorded Plat _____		
5. Private Claims _____		

Filed for Record in
ALCONA COUNTY MICHIGAN
DORIS A GAUTHIER
On 12-17-1998 At 05:34:44 pm.
LAND CORNER 9.00
OR

Alcona County
Instrumentation Page 327
Liber 1


APPROVED LAND CORNER
P A 345 of 1990
ALCONA COUNTY

Date: 10/21/98
County Rep: J.P.B. [Signature]

Register of Deeds Stamp & File Number

I, Thomas L. Fabis, in a field survey on May 27, 1998 do hereby state that under requirements of P.A. 74, Michigan P.A. of 1970, the corner points mentioned in lines 1 and 2 above were in conformance with regulations and rules therefore as required in the current manual of survey instructions of the United States Department of the Interior, Bureau of Land Management or by a decree of a Court of Law and /or that the corner points mentioned in lines 3, 4 and 5 above were in conformance with the rules of the Michigan Board of Land Surveyors or by a Decree of a Court of Law; established, re-established, monumented, recovered, found as expressed below:

NOTE: Not more than 2 corners, all in the same town and range, may be recorded on this certificate.

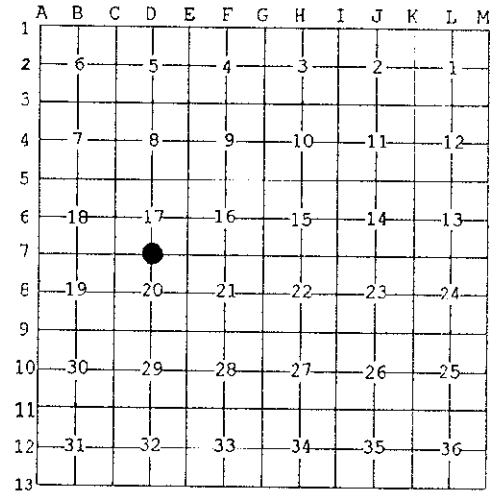

A. Description of original monument and accessories and/or subsequent restoration:

- 1840: G.L.O. Survey Thos. Pattison Set 1/4 Sec. Post & referenced: Beech 6 S50W 48, do 4 N51E 20.
- 1985: LCRC L.1 P.205 and Survey L.200 P.835 David Guthrie Set Forest Serv. Conc. Mon. 12" below surface. Raised with nail & referenced.
- 1987: R.S.Scott Survey W.O.1-1473 David Guthrie Exis. Conc. Mon. & referenced.

B. Description of corner evidence found and/or method applied in restoring or reestablishing corner:

- 1998: Found 60 Penny nail over existing Forest Service Concrete Monument with Brass cap 3' North of Black River Road centerline and found 60 Penny nails in the following witnesses:
P. Pole N40E 78.50'
10" Box Elder N48W 50.48'
Fe. Cor. Post S08W 32.49'

The position of this corner is compatible with local and Forest Service surveys and is accepted as a careful and faithful perpetuation of the position of the original corner.

C. Description of monument for corner and accessories established to perpetuate locating the position of the corner:

- 1998: Removed 60 Penny nail and set monument box around existing Forest Service Concrete Monument. 60 Penny nails are in the following three existing witnesses:
P. Pole N40E 78.50'
10" Box Elder N48W 50.48'
Fe. Cor. Post S08W 32.49'
Set tag #31591 in 6" Box Elder N20W 34.33'

Signed by Thomas L. Fabis Date December 11, 1998
Surveyor's Michigan License No. 31591

