

SURVEY & REMONUMENTATION

FEB 19 1999

1998 ALCONA COUNTY REMONUMENTATION CORNER

LAND CORNER RECORDATION CERTIFICATE

Filing Requirement of Act 74, Mich. P.A. 1970

SECTION
For corners in Alcona
(County)

Located In:

Corner Code #

Filed for Record in
ALCONA COUNTY MICHIGAN
DORIS A GAUTHIER
On 12-17-1998 At 05:34:47 pm.
LAND CORNER 9.00
OR

1. Public Land Survey	T	<u>28N</u>	R	<u>9E</u>	E-7
	T	_____	R	_____	Alcona Twp.
	T	_____	R	_____	_____
	T	_____	R	_____	_____
2. Property Controlling in Section	S	_____	T	_____	_____
	S	_____	T	_____	_____
3. Miscellaneous	S	_____	T	_____	_____
Property in Section	S	_____	T	_____	_____

Alcona County Remonumentation Page 322

APPROVED LAND CORNER
P A 345 of 1990
ALCONA COUNTY

Date: 10/21/98
County Rep: D. B. Lee

Register of Deeds Stamp & File Number

4. Lot No. _____, Recorded Plat _____
5. Private Claims _____

I, Thomas L. Fabis, in a field survey on May 27, 1998, do hereby certify that under requirements of P.A. 74, Michigan P.A. of 1970, the corner points mentioned in lines 1 and 2 above were in conformance with regulations and rules therefore as required in the current manual of survey instructions of the United States Department of the Interior, Bureau of Land Management or by a decree of a Court of Law and/or that the corner points mentioned in lines 3, 4 and 5 above were in conformance with the rules of the Michigan Board of Professional Surveyors or by a Decree of a Court of Law; established, re-established, monumented, re-monumented, recovered, found as expressed below:

NOTE: Not more than 4 corners, all in the same town and range, may be recorded on this certificate.

A. Description of original monument and accessories and/or subsequent restoration:

1840: G.L.O. Survey Thos. Pattison Set post & referenced.
1909: County Survey A.J. Freer Jr. Gray Boulder.
1913: County Survey Andrew J. Freer 2"x2½" iron.
1935: M.D.O.T. Plans File 01-1-8 C.S. 01052 Fnd. 2"x3" Iron Bar & referenced.
R.S.Scott Reference Surveys 1968: L.206 P.724, 1972: L.149 P.929, 1974: L.154 P.667 & 669.
David Guthrie Surveys Found 1/2" iron rod & referenced: 1977: L.167 P.452, 1978: L.169 P.643 & 644, 1981: W.O.1-1287 & W.O.1-1414, L.185 P.903 & 904.
1987 & 1988: Surveys Duane MacNeill L.218 P.684 & L.218 P.683 Found Conc. Mon.
1997: Survey W.O.1-2018 Larry Beauregard Found 1/2" Rod.

B. Description of corner evidence found and/or method applied in restoring or reestablishing corner:


1998: Found 60 Penny nail over Forest Service Conc. Mon. with brass cap at centerline of Bouchard Rd. and 3.1 feet South of Black River Road centerline. Found tag #18654 in the following witnesses: 5" Cedar N22E 42.49', Fe. Cor. Post S40E 50.06', 13" Aspen S30W 48.78'. Also, found 60 Penny nail in 9" Poplar S50E 54.62' and shiner in P. Pole N40W 74.62'.

The position of this corner is compatible with the local and Forest Service surveys and is accepted as a careful and faithful perpetuation of the position of the original corner.


C. Description of monument for corner and accessories established to perpetuate locating the position of the corner:

1998: Removed 60 Penny nail and set Monument Box around Forest Service Conc. Monument.
Witnesses are:

- Shiner in P. Pole N40W 74.62'
- 60 Penny nail in 9" Poplar S50E 54.62'
- Tag #18654 in 5" Cedar N22E 42.49'
- Tag #18654 in Fe. Cor. S40E 50.06'
- Tag #18654 in 13" Aspen S30W 48.78'

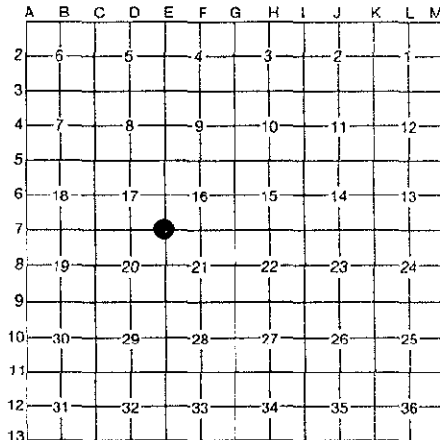

Signed by Thomas L. Fabis
Surveyor's Michigan License No. 31591

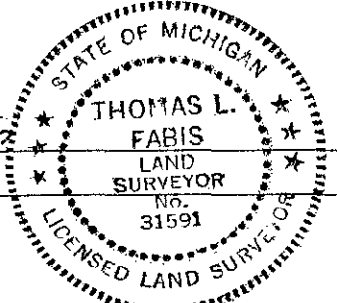

Date December 11, 1998