

FEB 19 1999

1998 ALCONA COUNTY REMONUMENTATION CORNER

LAND CORNER RECORDATION CERTIFICATE  
Filing Requirement of Act 74, Mich. P.A. 1970

SECTION

For corners in

<u>Alcona</u> (County)	Located In:	Corner Code #	
1. Public Land Survey	T <u>28NR 9E</u>	G-7	
	T ___ R ___	Alcona Twp.	
	T ___ R ___		
	T ___ R ___		
2. Property Controlling in Section	S ___ T ___ R ___		
	S ___ T ___ R ___		
3. Miscellaneous Property in Sec.	S ___ T ___ R ___		
	S ___ T ___ R ___		

Alcona County Remonumentation Liber Page 324

Filed for Record in  
ALCONA COUNTY MICHIGAN  
DORIS A GAUTHIER  
On 12-17-1998 At 05:34:53 pm.  
LAND CORNER 9.00  
OR

APPROVED LAND CORNER  
P A 345 of 1990  
ALCONA COUNTY  
Date 10/24/98  
County Rep [Signature]  
Register of Deeds Stamp & File Number

4. Lot No. \_\_\_\_\_, Recorded Plat \_\_\_\_\_  
5. Private Claims \_\_\_\_\_

I, Thomas L. Fabis, in a field survey on May 27, 1998 do hereby state that under requirements of P.A. 74, Michigan P.A. of 1970, the corner points mentioned in lines 1 and 2 above were in conformance with regulations and rules therefore as required in the current manual of survey instructions of the United States Department of the Interior, Bureau of Land Management or by a decree of a Court of Law and /or that the corner points mentioned in lines 3, 4 and 5 above were in conformance with the rules of the Michigan Board of Land Surveyors or by a Decree of a Court of Law; established, re-established, monumented, recovered, found as expressed below:

NOTE: Not more than 2 corners, all in the same town and range, may be recorded on this certificate.

A	B	C	D	E	F	G	H	I	J	K	L	M
1												
2	6	5	4	3	2	1						
3												
4	7	8	9	10	11	12						
5												
6	18	17	16	15	14	13						
7												
8	19	20	21	22	23	24						
9												
10	30	29	28	27	26	25						
11												
12	31	32	33	34	35	36						
13												


A. Description of original monument and accessories and/or subsequent restoration:  
 1840: G.L.O. Survey Thos. Pattison Set post & referenced: Cedar 18 S20W 29, Hem 12 N7E 27.  
 1985: LCRC L.1 P.190 & Survey L.200 P.834 David Guthrie Set Forest Service Conc. Mon. 12" below ground, raised with nail & referenced.  
 1987: Survey L.218 P.684 Duane MacNeill Found Conc. Mon.  
 1991: Survey L.240 P.103 Bill Woods FD. SPK.  
 1991: Survey Job No.21-289-3458-220591 Ties to corner from G-8 by Duane MacNeill.  
 1997: R.S.Scott Survey W.O.1-2018 Larry Beauregard Found D.E.Q. Mon. & referenced.

B. Description of corner evidence found and/or method applied in restoring or reestablishing corner:  
 1998: Found Forest Service Conc. Mon. with brass cap inters. of E-W & N-S road centerlines. Found the following references: Exis. tag #18654 in P. Pole N50E 63.32', Exis. tag #18654 in Anchor Pole S35E 49.39', Exis. 60 Penny nail in 13" Maple S37W 44.26', and U.S. Forest Service Post N30E 44.19'.

The position of this corner is compatible with local and Forest Service surveys and is accepted as a careful and faithful perpetuation of the position of the original corner.

C. Description of monument for corner and accessories established to perpetuate locating the position of the corner:  
 1998: Set monument box around existing Forest Service Concrete Monument. Witnesses are:  
 Exis. tag #18654 in P. Pole N50E 63.32'  
 Exis. tag #18654 in Anchor Pole S35E 49.39'  
 Exis. 60 Penny nail in 13" Maple S37W 44.26'  
 U.S. Forest Service Post N30E 44.19'

Signed by Thomas L. Fabis  
 Surveyor's Michigan License No. 31591

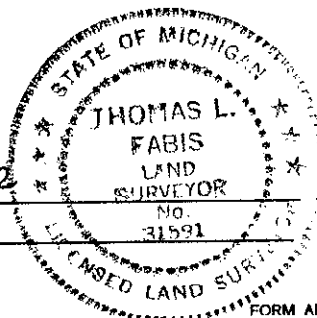

Date December 11, 1998