

REMONUMENTATION

FEB 19 1999

1998 ALCONA COUNTY REMONUMENTATION CORNER

LAND CORNER RECORDATION CERTIFICATE

Filing Requirement of Act 74, Mich. P.A. 1970

Filed for Record in ALCONA COUNTY MICHIGAN DORIS A GAUTHIER On 12-17-1998 At 05:34:55 pm. LAND CORNER 9.00 OR

SECTION

For corners in

Alcona (County)

Located In:

Corner Code #

- 1. Public Land Survey T 28N R 9E H-7 Alcona Twp.
2. Property Controlling in Section S T R
3. Miscellaneous Property in Section S T R

Alcona County Remonumentation Liber 1 Page 325

APPROVED LAND CORNER P A 345 of 1990 ALCONA COUNTY

Date 12/21/98 County Rep [Signature]

Register of Deeds Stamp & File Number

- 4. Lot No. Recorded Plat
5. Private Claims

I, Thomas L. Fabis, in a field survey on May 27, 1998, do hereby certify that under requirements of P.A. 74, Michigan P.A. of 1970, the corner points mentioned in lines 1 and 2 above were in conformance with regulations and rules therefore as required in the current manual of survey instructions of the United States Department of the Interior, Bureau of Land Management or by a decree of a Court of Law and/or that the corner points mentioned in lines 3, 4 and 5 above were in conformance with the rules of the Michigan Board of Professional Surveyors or by a Decree of a Court of Law; established, re-established, monumented, re-monumented, recovered, found as expressed below:

NOTE: Not more than 4 corners, all in the same town and range, may be recorded on this certificate.

A. Description of original monument and accessories and/or subsequent restoration:

- 1840: G.L.O. Survey Thos. Pattison Set post & referenced: Hem 20 S55W 16, Do 9 N54E 44.
1960: Green Acre Plat L.1 P.187A James Scott Ties corner to 1/8 line.
1976: Surveys L.163 P.498 & 500 Duane MacNeill Fnd. 1/2" Re-Rod & referenced.
1978: LCRC L.1 P.70 David Guthrie Existing 1" Pipe & referenced.
1988: Survey Job No.22-289-2349-138988 Duane MacNeill Measures from I-7.
1990: Survey Job No.22-289-2340-187290 Duane MacNeill Measures from I-7.
1991: Survey L.240 P.103 Bill Woods Fd. SPK.
1992: Survey L.281 P.692 Duane MacNeill Fnd. 1/2" Re-Rod & referenced.
1992: Survey Job No.22-289-4569-265592 Duane MacNeill Fnd. P.K. over survey pin.


B. Description of corner evidence found and/or method applied in restoring or reestablishing corner:

- 1998: Found 1" Pipe at the intersection of road centerlines and 2 existing witnesses:
Exis. shiner in P. Pole N10W 50.98'
Exis. shiner in P. Pole S45W 36.20'


The position of this corner is compatible with local and Forest Service surveys and is accepted as a careful and faithful perpetuation of the position of the original corner.

C. Description of monument for corner and accessories established to perpetuate locating the position of the corner:

- 1998: Removed existing 1" Pipe and replaced with 1/2" iron rod with a 3" dia. brass cap, stamped to identify the corner and set a Monument Box around the corner.
Witnesses are:
Exis. shiner in P. Pole N10W 50.98'
Exis. shiner in P. Pole S45W 36.20'
Set tags in 8" Bam N22W 39.19'
Set tags in 4" Bam S34E 56.68'

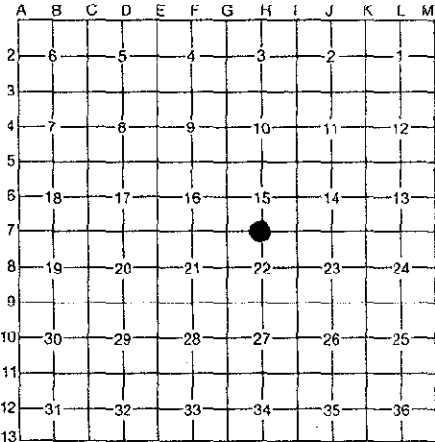

Signed by Thomas L. Fabis
Surveyor's Michigan License No. 31591

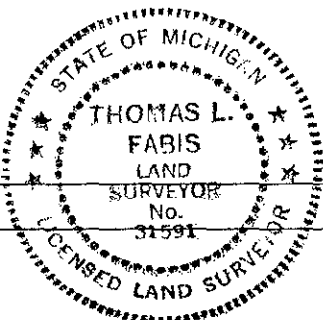

Date December 11, 1998