

SURVEY & REMONUMENTATION

FEB 19 1999

1998 ALCONA COUNTY REMONUMENTATION CORNER

LAND CORNER RECORDATION CERTIFICATE
 Filing Requirement of Act 74, Mich. P.A. 1970

For corners in **SECTION**

Alcona (County)	Located In:	Corner Code #
1. Public Land Survey	T 28 N R 9 E	I-7
	T R	Alcona Twp.
	T R	
	T R	
2. Property Controlling in Section	S T R	
	S T R	
3. Miscellaneous Property in Sec.	S T R	
	S T R	

Filed for Record in
 ALCONA COUNTY MICHIGAN
 DORIS A GAUTHIER
 On 12-17-1998 At 05:34:58 pm.
 LAND CORNER 9.00
 DR

ALCONA COUNTY
 REMONUMENTATION
 Page 326

APPROVED LAND CORNER
 P A 345 of 1990
 ALCONA COUNTY

Date 10/28/98
 County Rep. D. H. Lane

Register of Deeds Stamp & File Number

4. Lot No. _____, Recorded Plat _____
 5. Private Claims: _____

I, Thomas L. Fabis, in a field survey on May 27, 1998 do hereby state that under requirements of P.A. 74, Michigan P.A. of 1970, the corner points mentioned in lines 1 and 2 above were in conformance with regulations and rules therefore as required in the current manual of survey instructions of the United States Department of the Interior, Bureau of Land Management or by a decree of a Court of Law and /or that the corner points mentioned in lines 3, 4 and 5 above were in conformance with the rules of the Michigan Board of Land Surveyors or by a Decree of a Court of Law; established, re-established, monumented, recovered, found as expressed below:

NOTE: Not more than 2 corners, all in the same town and range, may be recorded on this certificate.

A	B	C	D	E	F	G	H	I	J	K	L	M
1												
2	6	5	4	3	2	1						
3												
4	7	8	9	10	11	12						
5												
6	18	17	16	15	14	13						
7												
8	19	20	21	22	23	24						
9												
10	30	29	28	27	26	25						
11												
12	31	32	33	34	35	36						
13												

A. Description of original monument and accessories and/or subsequent restoration:

- 1840: G.L.O. Survey Thos. Pattison Set post & referenced: Tam 10 S35E 36, Do 9 N10W 35.
- 1906: County Survey Edw. Chapelle Sr. Tam Post & referenced.
- 1940: County Survey A.J. Freer Visits corner & referenced.
- 1988: Survey Job No.22-289-2349-138988 Duane MacNeill Measures from H-7.
- 1988: LCRC L.1 P.335 & Survey L.224 P.835 & 837 Robert Mitchell Fnd. P.K. nail over 1" pipe. Removed & set Forest Service Conc. Mon. & referenced.
- 1990: Survey L.290 P.26 Duane MacNeill Measures from H-7.
- 1992: Survey L.281 P.692 Duane MacNeill Measures from H-7.
- 1993: Survey W.O.1-1780 David Guthrie Ex. Conc. Mon. & referenced.

B. Description of corner evidence found and/or method applied in restoring or reestablishing corner:

- 1998: Found Forest Service Conc. Mon. with brass cap 1.2 feet North of Black River Rd. centerline and at intersection with centerline of LaVigne Road. Also found three existing witnesses:
 Carsonite Post North 32.4'
 60 Penny Spike in 12" W. Birch N42W 80.88'
 60 Penny Spike in 13" W. Birch S30W 70.62'


The position of this corner is compatible with local and Forest Service surveys and is accepted as a careful and faithful perpetuation of the position of the original corner.

C. Description of monument for corner and accessories established to perpetuate locating the position of the corner:

- 1998: Set monument box around existing Forest Service Concrete Monument. Witnesses are:
 Exis. 60 Penny nail in 12" W. Birch N42W 80.88'
 Exis. 60 Penny nail in 13" W. Birch S30W 70.62'
 Set tag in P. Pole N48E 49.11'
 Set tag in P. Pole N58W 62.96'

Signed by

Thomas L. Fabis

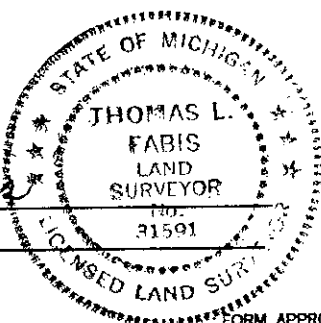

Date December 11, 1998

Surveyor's Michigan License No. 31591