

Approved by Alger County
Land Survey Remonumentation
Peer Group Under Act 345 of
P.A. of 1990 On 12-12-1995

Harold W. Carlson
Chairman

LAND CORNER RECORDATION CERTIFICATE
Filing Requirement of Act 74, Mich. P.A. 1970

SURVEY &
COMMISSION

MAR 26 1996

COMMISSION

4-343

For corners in Alger (County) Located In: Corner Code #

- | | | |
|--------------------------------------|-------------------|-----------|
| 1. Public Land Survey | T 45N R21W | A13 |
| | T 45N R22W | M13 |
| | T 44N R 21W | A1 |
| | T 44N R 22W | M11 |
| 2. Property Controlling in Section | S ___ T ___ R ___ | |
| | S ___ T ___ R ___ | |
| 3. Miscellaneous Property in Section | S ___ T ___ R ___ | |
| | S ___ T ___ R ___ | |

REC'D and FILED

MAR 23 1996

2:45 p.m.

DEPT. OF LAND & WATER, Alger County Clerk
ALGER COUNTY, MI 49711

Register of Deeds Stamp & File Number

4. Lot No. _____, Recorded Plat _____
5. Private Claims _____

A	B	C	D	E	F	G	H	I	J	K	L
2	6	5	4	3	2						
3											
4	7	8	9	10	11	12					
5											
6	18	17	16	15	14	13					
7											
8	19	20	21	22	23	24					
9											
10	30	29	28	27	26	25					
11											
12	31	32	33	34	35	36					
13											

I, Robert L. Jamros, in a field survey on June 12, 1995, 19_____, do hereby certify that under requirements of P.A. 74, Michigan P.A. of 1970, the corner points mentioned in lines 1 and 2 above were in conformance with regulations and rules therefore as required in the current manual of survey instructions of the United States Department of the Interior, Bureau of Land Management or by a decree of a Court of Law and/or that the corner points mentioned in lines 3, 4 and 5 above were in conformance with the rules of the Michigan Board of Professional Surveyors or by a Decree of a Court of Law; established, re-established, monumented, re-monumented, recovered, found as expressed below:

NOTE: Not more than 4 corners, all in the same town and range, may be recorded on this certificate.

A. Description of original monument and accessories and/or subsequent restoration:

A13: PLS-William A. Burt, DS, 1841, Set post corner of Towns 44 & 45 North between Ranges 21 & 22 West. - Sugar 16", N.50 W., 6 links, Sugar 15", S.27 E., 55 links. Alger County Road Commission, Edwin Swan, RLS, 1938 Alignment notes for Coaster Road. 3/4' bolt, references as follows, Maple 5", N.55 E., 59.0', Maple 4", N.71 W., 49.3'. Larry J. Bussone, RLS, 1989, Found iron five inches below gravel road surface. Corner checks well with Government calls to creek crossing to west. Established the following references. C/L Road, West, 2.0', Maple 20", N.83 E., 42.2', Basswood 12", N.88 W., 69.7', Maple 12", N.50 E., 72.8'


B. Description of corner evidence found and/or method applied in restoring or reestablishing corner:

A13: Found 3/4" x 24" square headed bolt author unknown, 0.7 feet east of centerline of road and six inches deep. Verified references of the 1989 LCRC report by Larry Bussone, RLS, 1989. A search was made at the GLO bearing tree locations, no evidence found. Installed new monument and established additional references. Corner position is accepted as the best available evidence of the original corner.

C. Description of monument for corner and accessories established to perpetuate locating the position of the corner:

A13: Replaced existing 3/4" bolt w/ 5/8" x 18" rebar w/ Berntsen Cap no. R8D5325 stamped to identify corner position. Renewed existing reference trees w/ BT signs and paint. Set PK nails for measure w/ Alum. I.D. washers in the following reference trees. Ex. Basswood 17", N.86 W., 70.16 feet, " Blz's w/ notches ", Ex. Maple 14", N.50 E., 73.00 feet, " Blz's w/ notches ", Ex. Maple 26", N.83 1/2 E., 43.21 feet, " Blz's w/ notches ", Survey Marker sign on six foot steel post, S.23 1/2 E., 70.02 feet, " Wit. Post ". All bearings are magnetic.

Signed by Robert L. Jamros
Surveyor's Michigan License No. 25849

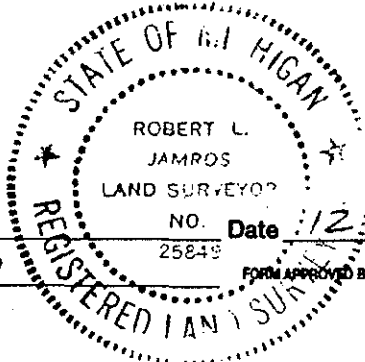

Date 12 December 1995