1. Public Land Survey — ALGER Co.

| | | | |
|---|---|---|---|
| | T 45N | R 21W | G-6 |
| | T 45N | R 21W | I-6 (WC) |
| | T 45N | R 21W | H-6 |
| | T ____ | R ____ | |
| 2. Property Controlling | S ____ T ____ | R ____ | |
| in Section | S ____ T ____ | R ____ | |
| 3. Miscellaneous | S ____ T ____ | R ____ | |
| Property in Sec. | S ____ T ____ | R ____ | |

ENG. / W.M. DIV.
LAND SURVEYS.

Register of Deeds Stamp & File Number

4. Lot No. _____ , Recorded Plat _____
5. Private Claims _____

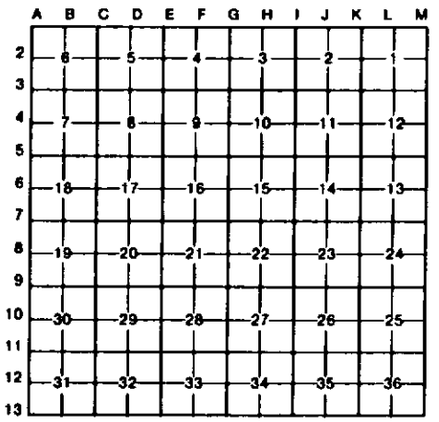


I, David Babbitt, in a field survey on April 30, 19 86, do hereby certify that under requirements of P.A. 74, Michigan P.A. of 1970, the corner points mentioned in lines 1 and 2 above were in conformance with regulations and rules therefore as required in the current manual of survey instructions of the United States Department of the Interior, Bureau of Land Management or by a decree of a Court of Law and/or that the corner points mentioned in lines 3, 4 and 5 above were in conformance with the rules of the Michigan Board of Land Surveyors or by a Decree of a Court of Law; established, re-established, monumented, re-monumented, recovered, found as expressed below:

**NOTE: Not more than 4 corners, all in the same town and range, may be recorded on this certificate.**

A. Description of original monument and accessories and/or subsequent restoration:

G6) West 1/4 corner of Section 15. Wood post. Sugar 8 - S40E - 4 Lks.
Fir 14 - N55W - 16 Lks.

I-6) (WC) Set wit. monument 100.0' south of E 1/4 corner of Section 15, on section line on south side of beaver pond. Original witness to 1/4 cor. Fir 10 West 20 links.
Fir 4 N14°E 29 links.

H6) Center of Section 15. Not previously established.

B. Description of corner evidence found and/or method applied in restoring or reestablishing corner:

G6) Set on line between the NW and SW section corners of Section 15 and in line with very old fences east and west. Corner falls in ℄ of Highway M-67. Mea. north to NW section corner is 2627.9' - Mea. south to SW section corner is 2685.0'.

I-6) (WC) Set DNR monument on east section line of Section 15 100.0' south of E 1/4 cor. (M.P.O.L.) which falls in a large beaver pond.

H6) Set at the intersection of the N-S and E-W 1/4 lines of Section 15.

C. Description of monument for corner and accessories established to perpetuate locating the position of the corner:

G6) 1" pipe w/plastic RLS Cap in Mon. box. Nail & brass tag inside of:
PP-S84W - 61.83'
12" maple - N84W - 81.99'
11" maple - N57E - 70.27'
14" maple - S73E - 63.42'

I-6) (WC) DNR Monument.
5" maple - S33°W - 36.8'
8" maple - S61°W - 34.6'
7" bl. cherry - S82°W - 11.05'
5" maple - S42°E - 12.5'

H6) DNR Monument.
9" maple - N3°W - 7.7'
6" balsam - S21°E - 9.2'
12" y.birch - N44°W - 21.4'
6" cedar - N75°E - 36.9'

Signed by David A Babbitt Date 5-12-86

Surveyor's Michigan License No. 21558