

JAN 28 1996

COMMISSION

4-342

Approved by Alger County  
Land Survey Remonumentation  
Peer Group Under Act 345 of  
P.A. of 1990 On 12-12-1995

Herold Carlson  
Chairman

LAND CORNER RECORDATION CERTIFICATE  
Filing Requirement of Act 74, Mich. P.A. 1970

For corners in  
Alger  
(County)

Located In:

Corner Code #

- |                                      |       |       |            |
|--------------------------------------|-------|-------|------------|
| 1. Public Land Survey                | T 45N | R 21W | <u>A12</u> |
|                                      | T 45N | R 22W | <u>M12</u> |
|                                      | T     | R     |            |
|                                      | T     | R     |            |
| 2. Property Controlling in Section   | S     | T     | R          |
|                                      | S     | T     | R          |
| 3. Miscellaneous Property in Section | S     | T     | R          |
|                                      | S     | T     | R          |
4. Lot No. \_\_\_\_\_, Recorded Plat \_\_\_\_\_
5. Private Claims \_\_\_\_\_

REC'D and FILED

DEC 29 1995  
2:45 p.m.

DEPT. OF LAND SURVEY, County Clerk  
ALGER COUNTY, MI

Register of Deeds Stamp & File Number

	A	B	C	D	E	F	G	H	I	J	K	L
2	6		5		4		3		2		1	
3												
4	7		8		9		10		11		12	
5												
6	18		17		16		15		14		13	
7												
8	19		20		21		22		23		24	
9												
10	30		29		28		27		26		25	
11												
12	31		32		33		34		35		36	
13												

I, Robert L. Jamros, in a field survey on June 12, 1995, 19\_\_\_\_\_, do hereby certify that under requirements of P.A. 74, Michigan P.A. of 1970, the corner points mentioned in lines 1 and 2 above were in conformance with regulations and rules therefore as required in the current manual of survey instructions of the United States Department of the Interior, Bureau of Land Management or by a decree of a Court of Law and/or that the corner points mentioned in lines 3, 4 and 5 above were in conformance with the rules of the Michigan Board of Professional Surveyors or by a Decree of a Court of Law; established, re-established, monumented, re-monumented, recovered, found as expressed below:

**NOTE: Not more than 4 corners, all in the same town and range, may be recorded on this certificate.**

**A. Description of original monument and accessories and/or subsequent restoration:**


A12: PLS-William A. Burt, DS, 1841, Set Or. Section Post- Maple 8", S.28 W., 28 links, Maple 13", N.60 E., 29 links. Alger County Road Commission, Edwin Swan, RLS, 1938 Alignment notes for Coaster Road. Corner position noted by road stationing only. Larry J. Bussone, RLS, 1989, Set 1/2" iron w/cap at mid-point between NE and SE section corners. Established the following references. C/L road, East, 1.0, Spruce 3", S.69 E., 23.1', P.Pole, S.23 W., 94.7', C/L Power line, West, 31.2'.

**B. Description of corner evidence found and/or method applied in restoring or reestablishing corner:**

A12: Found 1/2" x 18" rebar with cap missing 1.0 feet west of centerline of road and two inches deep. Corner position was reestablished by single proportionate measurement as stated in report by Larry Bussone, RLS, 1989. A search was made at GLO bearing tree locations, no evidence found. Installed new monument and established new references. Corner position is accepted as a careful and faithful reestablishment of the position of the original corner.

**C. Description of monument for corner and accessories established to perpetuate locating the position of the corner:**

A12: Replaced existing 1/2" rebar w/ 5/8" x 18" rebar w/ Berntsen Cap no. RBD5325 stamped to identify corner position. Established the following reference trees w/ BT signs, blazed, scribed and painted. Set PK nails for measure w/ Alum. I.D. washers in the following reference trees. Maple 7", S.67 W., 60.16 feet, " 1/4s BT ", Maple 7", N.43 W., 81.26 feet, " 1/4s BT ", Maple 6", N.58 E., 71.40 feet, " 1/4s BT ", Cherry 8", S.51 E., 51.77 feet, " 1/4s BT ". All bearings are magnetic.

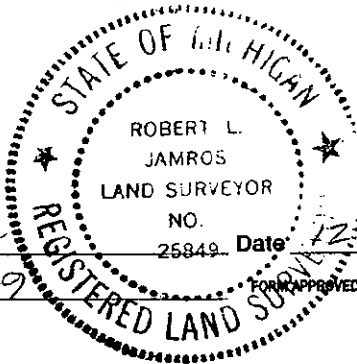

Signed by Robert L. Jamros  
Surveyor's Michigan License No. 25849

Date 12 December 1995