

Approved by Alger County
Land Survey Remonumentation
Peer Group Under Act 345 of
P.A. of 1990 On 12-12-1995

Donald W. Carlson
Chairman

LAND CORNER RECORDATION CERTIFICATE
Filing Requirement of Act 74, Mich. P.A. 1970

**SURVEY &
REMONUMENTATION**

JAN 23 1996

COMMISSION

4-345

For corners in Alger Located In: Corner Code #
(County)

- | | | | | | |
|--------------------------------------|---|------------|---|------------|----|
| 1. Public Land Survey | T | <u>45N</u> | R | <u>21W</u> | B9 |
| | T | | R | | |
| | T | | R | | |
| | T | | R | | |
| 2. Property Controlling in Section | S | | T | | R |
| | S | | T | | R |
| 3. Miscellaneous Property in Section | S | | T | | R |
| | S | | T | | R |

REC'D and FILED

DEC 20 1995

2:45 p.m.

DONALD W. KINNUNEN County Clerk
ALGER COUNTY, MI

Register of Deeds Stamp & File Number

4. Lot No. _____, Recorded Plat _____
5. Private Claims _____

I, Robert L. Jamros, in a field survey on November 01, 19 95, do hereby certify that under requirements of P.A. 74, Michigan P.A. of 1970, the corner points mentioned in lines 1 and 2 above were in conformance with regulations and rules therefore as required in the current manual of survey instructions of the United States Department of the Interior, Bureau of Land Management or by a decree of a Court of Law and/or that the corner points mentioned in lines 3, 4 and 5 above were in conformance with the rules of the Michigan Board of Professional Surveyors or by a Decree of a Court of Law; established, re-established, monumented, re-monumented, recovered, found as expressed below:

NOTE: Not more than 4 corners, all in the same town and range, may be recorded on this certificate.

A	B	C	D	E	F	G	H	I	J	K	L	M
2	6		5		4		3		2			
3												
4	7		8		9		10		11		12	
5												
6	18		17		16		15		14		13	
7												
8	19		20		21		22		23		24	
9												
10	30		29		28		27		26		25	
11												
12	31		32		33		34		35		36	
13												

A. Description of original monument and accessories and/or subsequent restoration:


B9: PLS-Zelotes B. Searls, DS, 1850, Set Qr. Section Post- Sugar 8", S.10 E., 7 links, Sugar 26", N.10 W., 4 links. George Depew, County Surveyor, 1917, Set standard iron corner from government field notes. No references given. Record of surveys book, Page 420, Alger County Records. No other subsequent restoration.

B. Description of corner evidence found and/or method applied in restoring or reestablishing corner:

B9: Found 2 1/4" galvanized iron pipe with 3 1/4" brass cap stamped to identify corner position, dated November 22, 1917. Located corner position by measurement from the northeast corner of section. A search was made at the GLO bearing tree locations, no evidence found. Corner position is accepted as a careful and faithful perpetuation of the position of the original corner.

C. Description of monument for corner and accessories established to perpetuate locating the position of the corner:

B9: Stamped P.A. 345 in brass cap of cast steel Monument. Established the following reference trees w/ BT signs, blazed, scribed and painted. Set PK nails for measure w/ Alum. I.D. washers in the following reference trees. Cedar 8", N.47 W., 112.62 feet, " 1/4s BT ", Twin Maple 8", S.16 E., 3.22 feet, " 1/4s BT ", Maple 7", N.50 E., 63.95 feet, " 1/4s BT ", Survey Marker sign on six foot steel post, S.58 W., 3.91 feet, " Wit. Post ". All bearings are magnetic.

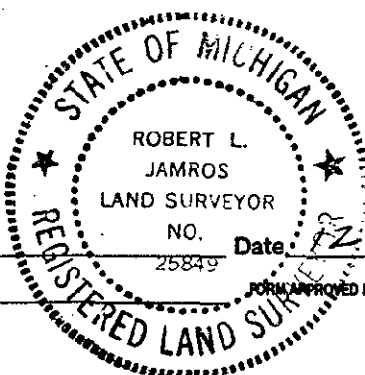

Signed by Robert L. Jamros
Surveyor's Michigan License No. 25849

Date: 12 December 1995