

Gerald Carlson  
 Chairman

**LAND CORNER RECORDATION CERTIFICATE**  
 Filing Requirement of Act 74, Mich. P.A. 1970

5-22

For corners in ALGER Located In: \_\_\_\_\_ Corner Code # \_\_\_\_\_  
 (County)

1. Public Land Survey T 45N R 21W D1  
T 46N R 21W D13  
 T \_\_\_\_\_ R \_\_\_\_\_  
 T \_\_\_\_\_ R \_\_\_\_\_
2. Property Controlling in Section S \_\_\_\_\_ T \_\_\_\_\_ R \_\_\_\_\_  
 S \_\_\_\_\_ T \_\_\_\_\_ R \_\_\_\_\_
3. Miscellaneous Property in Section S \_\_\_\_\_ T \_\_\_\_\_ R \_\_\_\_\_  
 S \_\_\_\_\_ T \_\_\_\_\_ R \_\_\_\_\_
4. Lot No. \_\_\_\_\_, Recorded Plat \_\_\_\_\_
5. Private Claims \_\_\_\_\_


FILED  
 TIME 2:00 pm

MAR 31 1997

DONALD W. KINNUNEN  
 REGISTER OF DEEDS  
 ALGER COUNTY, MI

Register of Deeds Stamp & File Number

I, Robert L. Jamros, in a field survey on August 30, 1996, 19\_\_\_\_\_, do hereby certify that under requirements of P.A. 74, Michigan P.A. of 1970, the corner points mentioned in lines 1 and 2 above were in conformance with regulations and rules therefore as required in the current manual of survey instructions of the United States Department of the Interior, Bureau of Land Management or by a decree of a Court of Law and/or that the corner points mentioned in lines 3, 4 and 5 above were in conformance with the rules of the Michigan Board of Professional Surveyors or by a Decree of a Court of Law; established, re-established, monumented, re-monumented, recovered, found as expressed below:

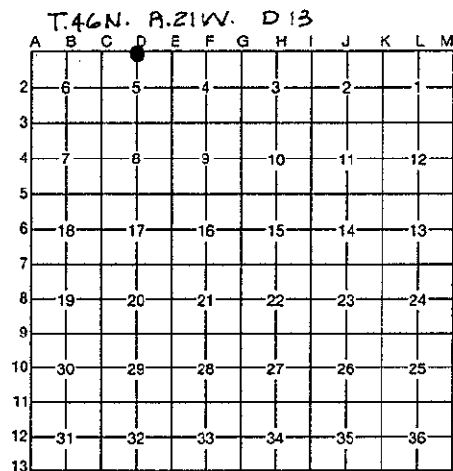

**NOTE: Not more than 4 corners, all in the same town and range, may be recorded on this certificate.**

**A. Description of original monument and accessories and/or subsequent restoration:**

D1: PLS - William A. Burt, DS, 1841, Set quarter Section post \* Sugar 8, N.32 E., 22 links \* Sugar 16, N.65 W., 39 links \*\*\*\* Herbert L. Fluharty, RLS, 1975. \* Found 3/4" Pipe at intersection of roads, Author unknown. P.P., N.45 E., 45.09 feet. \* Stop sign base, N.20 W., 53.21 feet. \* Stop sign base, S.17-E., 53.05 feet. \* Recorded in L.1, P.76, Alger County Records. \*\*\*\* Robert L. Jamros, RLS, 1990. \* Alger County Road Commission Project for the rehabilitation of Tunteri Road from the Eben-Trenary Road East two miles to the intersection of State Highways M-94 and M-67. \* Existing 3/4" Iron pipe monument at this corner position recovered during the centerline alignment and preliminary survey work for this project. Corner position documented on construction plans of Tunteri Road, Alger Count. \* Not recorded.


**B. Description of corner evidence found and/or method applied in restoring or reestablishing corner:**

D1: Established corner position by standard survey methods and references based on 1990 centerline alignment plans of the Tunteri Road. Corner position lies 1.8 feet North of centerline of Tunteri Road and on centerline of gravel road North and South. Installed monument at corner position and established references. Monumented corner position was established from the best available evidence and is accepted as a careful and faithful reestablishment of the position of the original corner.

**C. Description of monument for corner and accessories established to perpetuate locating the position of the corner:**

D1: Set 5/8" x 18" Rebar with a 3 1/4" Berntsen Aluminum cap no. R8D 5325, stamped to identify corner position. \* Set PK nails with Aluminum I.D. washers for measure in the following reference objects. \* Street sign 2 1/4" G.I.P., N.41 W., 47.19 feet. \* Exist. 8T, Power Pole, N.49 E., 44.94 feet to PK nail. \* Power Pole, -S.09 E., 134.95 feet to PK nail. \* Cedar Post 4" no. 367, S.44 W., 44.64 feet. to PK nail. \* All bearings are magnetic.

Signed by Robert L. Jamros  
 Surveyor's Michigan License No. 25849

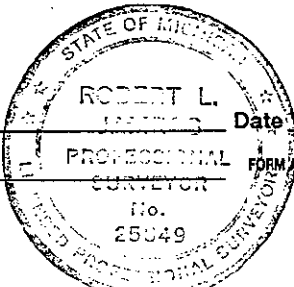

Date 25 March, 1997