

AUG 15 1997

COMMISSION 5-17

Approved by Alger County Land Survey Remonumentation Peer Group Under Act 845 of P.A. of 1980 On 3-24-1997


Harold Carlson  
Chairman

LAND CORNER RECORDATION CERTIFICATE  
Filing Requirement of Act 74, Mich. P.A. 1970

For corners in ALGER (County)	Located In:	Corner Code #
1. Public Land Survey	T 45N R 21W	D5
	T _____ R _____	_____
	T _____ R _____	_____
	T _____ R _____	_____
2. Property Controlling in Section	S _____ T _____ R _____	_____
	S _____ T _____ R _____	_____
3. Miscellaneous Property in Section	S _____ T _____ R _____	_____
	S _____ T _____ R _____	_____

FILED  
 TIME 2:00 pm  
 MAR 31 1997  
 DONALD W. KINNUNEN  
 REGISTER OF DEEDS  
 ALGER COUNTY, MI  
 Register of Deeds Stamp & File Number

4. Lot No. \_\_\_\_\_, Recorded Plat \_\_\_\_\_  
 5. Private Claims \_\_\_\_\_

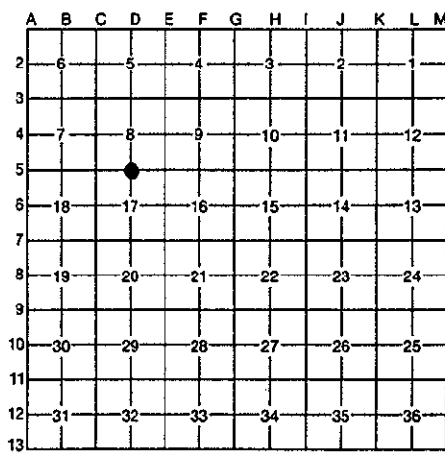

I, Robert L. Janros, in a field survey on September 18, 1996, 19\_\_\_\_\_, do hereby certify that under requirements of P.A. 74, Michigan P.A. of 1970, the corner points mentioned in lines 1 and 2 above were in conformance with regulations and rules therefore as required in the current manual of survey instructions of the United States Department of the Interior, Bureau of Land Management or by a decree of a Court of Law and/or that the corner points mentioned in lines 3, 4 and 5 above were in conformance with the rules of the Michigan Board of Professional Surveyors or by a Decree of a Court of Law; established, re-established, monumented, re-monumented, recovered, found as expressed below:

NOTE: Not more than 4 corners, all in the same town and range, may be recorded on this certificate.

A. Description of original monument and accessories and/or subsequent restoration:

D5: PLS - Z.B. Searls, DS, 1850, Set quarter Section post \* Hemlock 12, S.39 W., 23 links \* Fir 8, N.20 E., 10 links \*\*\*\* Michael D. Mileski, LPS, 1995. \* George L. Depew, CS, 1918. \* Surveyed from the N.W. corner of Section 17 noting topographic calls referenced to road stationing as part of road work for Rock River Township. \* Reestablished corner position midway and on line between fence Kingposts to the North and South. Corner position falls in the physical centerline of East-West county road. \* Set 1/2" x 18" iron rod with cap 6" below the road surface. \* 20" Twin Cedar, N.06 E., 39.13 feet, to 60d spike. \* 10" Sugar Maple, S.39 E., 132.60 feet, to 60d spike. \* 14" Balsam, S.19 E., 103.85 feet, to 60d spike. \* 6" Sugar Maple, N.80 W., 129.00 feet, to 60d spike. \* All bearing trees have upper and lower blazes and scribed "NBT". \* Recorded in L.4, P.391, Alger County Records.


B. Description of corner evidence found and/or method applied in restoring or reestablishing corner:

D5: Found 1/2" Rebar with cap no. 39091, 4" below grade of gravel County Road. \* Made measurements to corners East and West and corner position is at an acceptable location. Corner position lines with existing fences North and South and lies on centerline of existing County Road. \* Verified existing references. \* Monument at existing corner position is accepted as a careful and faithful reestablishment of the position of the original corner.

C. Description of monument for corner and accessories established to perpetuate locating the position of the corner:

D5: Replaced existing 1/2" rebar with a 5/8" x 18" rebar with a 3 1/4" Berntson Aluminum cap stamped to identify corner position. \* Renewed existing references with BT signs and paint. Exist. BT, Twin Cedar 20", N.11 E., 39.01 feet to exist. spike. \* Exist BT, Twin Maple 5 7/8", S.34 E., 132.54 feet to exist. spike. \* Exist. BT, Balsam 14", S.15 E., 103.85 feet to exist. spike. \* Exist. BT, Twin Maple 5 7/8", N.75 W., 129.00 feet to exist. spike. \* All bearings are magnetic.

Signed by Robert L. Janros  
 Surveyor's Michigan License No. 25849

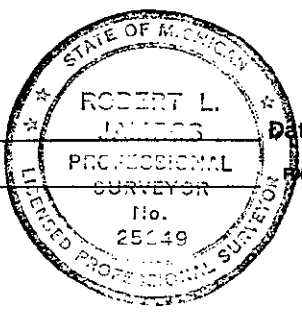

Date 25 March, 1997