

Approved by Alger County
Land Survey Department
Peer Group Under Act 74 of
P.A. of 1990 On 3-24-1997

Gerald Carlson
Chairman

LAND CORNER RECORDATION CERTIFICATE
Filing Requirement of Act 74, Mich. P.A. 1970

5-23

For corners in ALGER Located In: _____ Corner Code # _____
(County)

FILED
TIME 2:00pm

MAR 31 1997

DONALD W. KINNUNEN
REGISTER OF DEEDS
ALGER COUNTY, MI

Register of Deeds Stamp & File Number

1. Public Land Survey T 45N R 21W H1
T 46N R 21W H13
T _____ R _____
T _____ R _____
2. Property Controlling S _____ T _____ R _____
in Section S _____ T _____ R _____
3. Miscellaneous S _____ T _____ R _____
Property in Section S _____ T _____ R _____
4. Lot No. _____, Recorded Plat _____
5. Private Claims _____

		T. 46N.			R. 21W.			H 13					
	A	B	C	D	E	F	G	H	I	J	K	L	M
2	6		5		4		3		2				
3													
4	7		8		9		10		11		12		
5													
6	18		17		16		15		14		13		
7													
8	19		20		21		22		23		24		
9													
10	30		29		28		27		26		25		
11													
12	31		32		33		34		35		36		
13													

I, Robert L. Jamros, in a field survey on August 30, 1996, 19_____, do hereby certify that under requirements of P.A. 74, Michigan P.A. of 1970, the corner points mentioned in lines 1 and 2 above were in conformance with regulations and rules therefore as required in the current manual of survey instructions of the United States Department of the Interior, Bureau of Land Management or by a decree of a Court of Law and/or that the corner points mentioned in lines 3, 4 and 5 above were in conformance with the rules of the Michigan Board of Professional Surveyors or by a Decree of a Court of Law; established, re-established, monumented, re-monumented, recovered, found as expressed below:

NOTE: Not more than 4 corners, all in the same town and range, may be recorded on this certificate.

A. Description of original monument and accessories and/or subsequent restoration:

H1: PLS - William A. Burt, DS, 1841, Set quarter Section post * Sugar 24, N.63 W., 44 links **** Corner shown on M.S.H.D. State Trunkline Plans at Alger County Road Commission. * Surveyed and mapped by G.L. Depew, CS, 1919. * No references or monument material shown or given. **** M.S.H.D., 1959 Project, Munising-Chatham Road. * One quarter line shown at highway station 563+28. * No monument documented or shown.


B. Description of corner evidence found and/or method applied in restoring or reestablishing corner:

H1: No existing monument found. Set corner position midway and on line between Section corners, East and West. Overall distance between Section corners measures 5273.18 feet. Highway has been lifted over the past years Ten plus feet above original ground North and South of roadbed. At some distance South there is an apparent occupation line in the topography. Monumented corner position as set and established new references. Corner position as set is accepted as a careful and faithful reestablishment of the position of the original corner.

C. Description of monument for corner and accessories established to perpetuate locating the position of the corner:

H1: Set 5/8" x 18" Rebar with 3 1/4" Bernstein Aluminum cap no. RBD 5325, stamped to identify corner position. Set PK nails with Aluminum I.D. washers for measure in the following reference objects. * 6" Maple, N.56 W., 119.54 feet, BT signs, lower blaze scribed "BT", painted. * 12" "Y" Maple, S.23 W., 83.09 feet, BT signs, lower blaze, scribed "BT", painted. * P. Pole, S.52 E., 123.49 feet, scribed "BT" at base. * 4" Spruce, N.48 E., 63.75 feet, BT signs, lower blaze scribed "BT", painted. * All bearings are magnetic.

Signed by Robert L. Jamros
Surveyor's Michigan License No. 25849

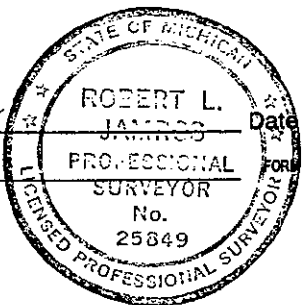

Date 25 March, 1997

FOR APPROVED BY MICHIGAN STATE BOARD OF PROFESSIONAL SURVEYORS, JAN. 28, 1971
REVISED MAY 14, 1975
REVISED JAN., 1983