Approved by Alger County
Land Survey Remonumentation
Peer Group Under Act 345 of
P.A. of 1990 On 6-21 1994

Gerald W Carlson
Chairman

LAND CORNER RECORDATION CERTIFICATE

Filing Requirement of Act 74, Mich. P.A. 1970

4-255

For corners in
Alger
(County)

	Located In:	Corner Code ##
1. Public Land Survey	T 45N R 21W	I3
	T ___ R ___	
	T ___ R ___	
	T ___ R ___	
2. Property Controlling	S ___ T ___ R ___	
in Section	S ___ T ___ R ___	
3. Miscellaneous	S ___ T ___ R ___	
Property in Sec.	S ___ T ___ R ___	

Recorded July 15, 1994
at 8:00 o'clock A. M., and
Recorded in Liber 4 of Cor. Rec.
on Page 255

Alger County Register of Deeds

Register of Deeds Stamp & File Number

4. Lot No. _____, Recorded Plat _____
5. Private Claims _____

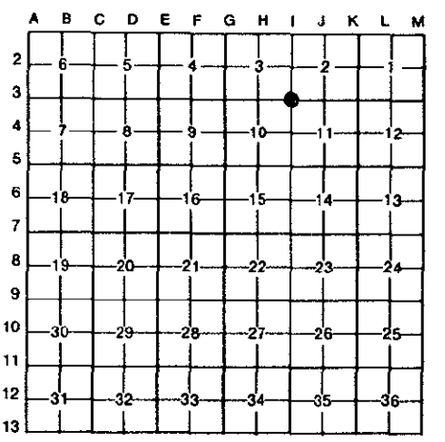

I, Robert L. Jamros, in a field survey on July 22, 1993, 19 ____, do hereby certify that under requirements of P.A. 74, Michigan P.A. of 1970, the corner points mentioned in lines 1 and 2 above were in conformance with regulations and rules therefore as required in the current manual of survey instructions of the United States Department of the Interior, Bureau of Land Management or by a decree of a Court of Law and/or that the corner points mentioned in lines 3, 4 and 5 above were in conformance with the rules of the Michigan Board of Land Surveyors or by a Decree of a Court of Law; established, re-established, monumented, re-monumented, recovered, found as expressed below:

NOTE: Not more than 4 corners, all in the same town and range, may be recorded on this certificate.

A. Description of original monument and accessories and/or subsequent restoration:

I3: P.L.S., Z.B. Searls, DS, 1850. Set post cor. of Sec's 2, 3, 10, & 11. Spruce 10, S.70 E., 17 links. George Depew, C.S., set iron monument at S.E. Section corner of Section 3. Tamarack 12, N.41 W., 29 links. David Babbitt, R.L.S., October 1985. Set D.N.R. monument in centerline of East-West road and in line with old fence South. George Depew's Brass capped monument could not be found. I believe fence was set by Depew's survey. Established reference objects, 8" Tamarack, N.12 E., 50.5 feet, 8" Tamarack, N.36 W., 64.8 feet, 20" W. Pine, S.44 E., 56.2 feet, 4" Hemlock, S.22 W., 53.0 feet. Recorded in filing No. 212, Alger County records.

B. Description of corner evidence found and/or method applied in restoring or reestablishing corner:

I3: Found D.N.R. monument, identified by recorded reference objects, badly bent, cap missing on centerline of East-West road at fence to South, down. Of the recorded witness points, all remain intact. Found 10" cedar fence post w/rusted D.N.R. location tag, N.06 E., 37.9 feet. Installed new monument 10" below road surface in the centerline of hole remaining from D.N.R. monument. Existing reference points brought up to current standards and is accepted as the best available evidence of the position of the original corner.

C. Description of monument for corner and accessories established to perpetuate locating the position of the corner:

I3: Installed 5/8" x 18" rebar w/3 1/4" alum cap, stamped to I.D. corner position. Renewed existing reference trees w/BT signs, blazed, scribed and painted. Set PK nails for measuring w/brass I.D. washers in the following reference trees. Ex. Tamarack 8", N.11 E., 50.73 feet, "S2-NBT". Ex. Tamarack 10" N.39 W., 65.14 feet, "S3-NBT". Ex. Hemlock 5", S.19 W., 53.12 feet, Scribed. Ex. W.Pine 24", S.46 E., 57.05 feet, Scribed.

Signed by Robert L. Jamros Date 1 June, 1994

Surveyor's Michigan License No. 25849

FORM APPROVED BY MICHIGAN STATE BOARD OF LAND SURVEYORS, JAN. 28, 1971
REVISED MAY 14, 1975
REVISED JAN., 1983