

Approved by Alger County
Land Survey Remonumentation
Peer Group Under Act 345 of
P.A. of 1990 On 12-12-1995

SURVEY &
MONUMENTATION

JAN 23 1996

COMMISSION

4-346

REC'D and FILED

DEC 20 1995

2:45 p.m.

DONALD W. JONES, County Clerk
ALGER COUNTY, MI

Register of Deeds Stamp & File Number

LAND CORNER RECORDATION CERTIFICATE
Filing Requirement of Act 74, Mich. P.A. 1970

For corners in Alger (County)	Located In:	Corner Code #
1. Public Land Survey	T 45N R21W	I4
	T _____ R _____	_____
	T _____ R _____	_____
	T _____ R _____	_____
2. Property Controlling in Section	S _____ T _____ R _____	_____
	S _____ T _____ R _____	_____
3. Miscellaneous Property in Section	S _____ T _____ R _____	_____
	S _____ T _____ R _____	_____
4. Lot No. _____, Recorded Plat _____		
5. Private Claims _____		

A	B	C	D	E	F	G	H	I	J	K	L
2	6	5	4	3	2	1					
3											
4	7	8	9	10	11	12					
5											
6	18	17	16	15	14	13					
7											
8	19	20	21	22	23	24					
9											
10	30	29	28	27	26	25					
11											
12	31	32	33	34	35	36					
13											

I, Robert L. Jamros, in a field survey on June 13, 1995, 19_____, do hereby certify that under requirements of P.A. 74, Michigan P.A. of 1970, the corner points mentioned in lines 1 and 2 above were in conformance with regulations and rules therefore as required in the current manual of survey instructions of the United States Department of the Interior, Bureau of Land Management or by a decree of a Court of Law and/or that the corner points mentioned in lines 3, 4 and 5 above were in conformance with the rules of the Michigan Board of Professional Surveyors or by a Decree of a Court of Law; established, re-established, monumented, re-monumented, recovered, found as expressed below:

NOTE: Not more than 4 corners, all in the same town and range, may be recorded on this certificate.

A. Description of original monument and accessories and/or subsequent restoration:

I4: PLS-Zelotes B. Searls, DS, 1850, Set Qr. Section Post- Sugar 8', S.39 W., 29 links, Sugar 10', N.74 E., 14 links. No Subsequent Restoration prior to 1986. David B. Babbitt, RLS, 1986, Set corner mid-point on line between the Northwest and Southwest section corners. Established the following references. Maple 5', S.65 E., 42.1', Maple 4', N.09 W., 36.7', Maple 10', N.81 W., 49.0', Maple 6', S.29 W., 8.0'. Recorded in Filing No. 213, Alger County Records.

B. Description of corner evidence found and/or method applied in restoring or reestablishing corner:

I4: Found 1 1/4" galvanized iron pipe with 3 3/4" Aluminum cap in open area of cultivated fields and fences to the north and east. Corner position was reestablished by single proportionate measurement as stated in report by David B. Babbitt, RLS, 1985. Verified references of the 1985 LCRC report. A search was made at GLO bearing tree locations, no evidence found. Line fences running North and East from corner position. Corner position is accepted as a careful and faithful reestablishment of the position of the original corner.

C. Description of monument for corner and accessories established to perpetuate locating the position of the corner:


I4: Stamped P.A. 345 in existing 3 3/4" Aluminum capped Michigan D.N.R. Monument. Renewed existing reference trees w/ BT signs and paint. Set PK nails for measure w/ Alum. I.D. washers in thr following reference trees. Ex. Maple 5', N.09 W., 36.96 feet, " Dbl. Blz'd. and scribed ", Ex. Maple 10', N.81 W., 49.31 feet, " Dbl. Blz'd. and scribed ", Ex. Maple 6', S.29 W., 8.22 feet, " Dbl. Blz'd. and scribed ", Ex. Maple 6', S.63 1/2 E., 42.44 feet, " Dbl. Blz'd. and scribed ", Survey Marker sign on six foot steel post, N.80 E., 0.80 feet. All bearings are magnetic.

Signed by

Robert L. Jamros

Surveyor's Michigan License No.

25849

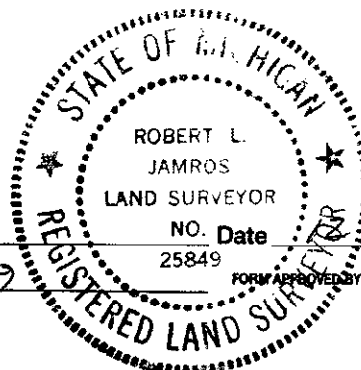

NO. Date

December 1995