

Approved by Alger County  
Land Survey Remonumentation  
Peer Group Under Act 345 of  
P.A. of 1990 On 12-12-1995

JAN 23 1996

COMMISSION

4-344

**LAND CORNER RECORDATION CERTIFICATE**  
Filing Requirement of Act 74, Mich. P.A. 1970

Gerald W. Carlson  
Chairman

For corners in  
Alger  
(County)

Located In:

Corner Code #

1. Public Land Survey	T	45N	R 21W	I9
	T		R	
	T		R	
	T		R	
2. Property Controlling in Section	S	T	R	
	S	T	R	
3. Miscellaneous Property in Section	S	T	R	
	S	T	R	

REC'D and FILED


DEC 20 1995

2:45 p.m.

DONALD W. KIRKINEN, County Clerk  
ALGER COUNTY, MI

Register of Deeds Stamp & File Number

4. Lot No. \_\_\_\_\_, Recorded Plat \_\_\_\_\_  
5. Private Claims \_\_\_\_\_

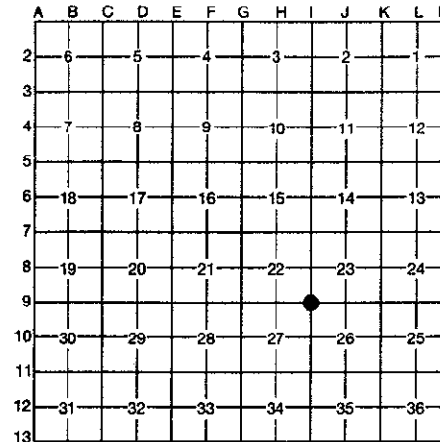

I, Robert L. Jamros, in a field survey on November 01, 1995, 19\_\_\_\_\_, do hereby certify that under requirements of P.A. 74, Michigan P.A. of 1970, the corner points mentioned in lines 1 and 2 above were in conformance with regulations and rules therefore as required in the current manual of survey instructions of the United States Department of the Interior, Bureau of Land Management or by a decree of a Court of Law and/or that the corner points mentioned in lines 3, 4 and 5 above were in conformance with the rules of the Michigan Board of Professional Surveyors or by a Decree of a Court of Law; established, re-established, monumented, re-monumented, recovered, found as expressed below:

**NOTE: Not more than 4 corners, all in the same town and range, may be recorded on this certificate.**

**A. Description of original monument and accessories and/or subsequent restoration:**

I9: PLS- Zelotes B. Searls, DS, 1850, Set post corner of sections 22,23,26 & 27 - Sugar 10", S.39 E., 13 links, Sugar 10", N.30 W., 33 links. George L. Depew, County surveyor, 1917, Set iron corner from government field notes, No references given. Record of surveys book page 368, Alger county records. Robert L. Jamros, RLS, 1979, Found 1 3/4" pipe with brass cap in good condition. Established the following new references: Maple 20", N.20 W., 24.0 feet, Maple 6", S.22 E., 25.3 feet, Maple 6", N.45 W., 26.2 feet, Maple 6", S.33 W., 36.6 feet.


**B. Description of corner evidence found and/or method applied in restoring or reestablishing corner:**

I9: Found 2 1/4" galvanized iron pipe with 3 1/4" brass cap stamped to identify corner position, dated OCT. 23, 1917. A search was made at GLO bearing tree locations, no evidence found. Verified the references of the 1979 LCRC report, by Robert L. Jamros, RLS. Established additional references. Corner position is accepted as a careful and faithful perpetuation of the position of the original corner.

**C. Description of monument for corner and accessories established to perpetuate locating the position of the corner:**

I9: Stamped P.A. 345 in brass cap of cast steel monument. Established the following reference trees w/ BT signs, blazed, scribed and painted. Set PK nails for measure w/ Alum. I.D. washers in the following reference trees. Cedar 7", S.37 E., 4.63 feet, " S26 BT ", Cedar 7", S.76 W., 24.55 feet, " S27 BT ", Twin Maple 8", N.37 W., 68.16 feet, " S22 BT ", Maple 11", N.31 E., 37.13 feet, " S23 BT ", Survey Marker sign on six foot steel post, S.46 W., 1.2 feet. All bearings are magnetic.

Signed by Robert L. Jamros  
Surveyor's Michigan License No. 25849

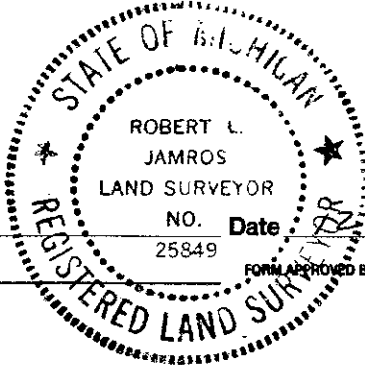

Date 22 December 1995