

Approved by Alger County  
Land Survey Remonumentation  
Peer Group Under Act 345 of  
P.A. of 1990 On 12-12-1995

JAN 23 1996

COMMISSION

4-347

REC'D and FILED

DEC 20 1995  
2:45 p.m.

DONALD W. KIRKUMEN, County Clerk  
ALGER COUNTY, MI


Register of Deeds Stamp & File Number

LAND CORNER RECORDATION CERTIFICATE  
Filing Requirement of Act 74, Mich. P.A. 1970

For corners in Alger (County)	Located In:	Corner Code #
1. Public Land Survey	T 45N R21W	J5
	T _____ R _____	_____
	T _____ R _____	_____
	T _____ R _____	_____
2. Property Controlling in Section	S _____ T _____ R _____	_____
	S _____ T _____ R _____	_____
3. Miscellaneous Property in Section	S _____ T _____ R _____	_____
	S _____ T _____ R _____	_____

4. Lot No. \_\_\_\_\_, Recorded Plat \_\_\_\_\_  
5. Private Claims \_\_\_\_\_

I, Robert L. Jamros, in a field survey on June 12, 1995, 19\_\_\_\_\_, do hereby certify that under requirements of P.A. 74, Michigan P.A. of 1970, the corner points mentioned in lines 1 and 2 above were in conformance with regulations and rules therefore as required in the current manual of survey instructions of the United States Department of the Interior, Bureau of Land Management or by a decree of a Court of Law and/or that the corner points mentioned in lines 3, 4 and 5 above were in conformance with the rules of the Michigan Board of Professional Surveyors or by a Decree of a Court of Law; established, re-established, monumented, re-monumented, recovered, found as expressed below:

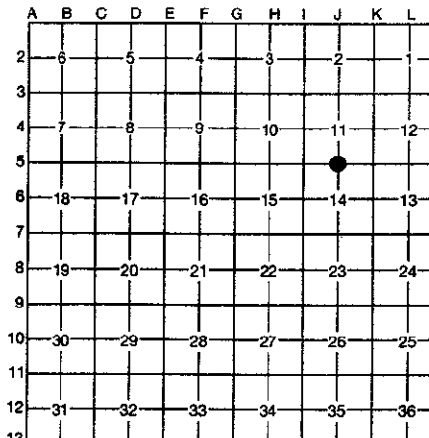

**NOTE: Not more than 4 corners, all in the same town and range, may be recorded on this certificate.**

**A. Description of original monument and accessories and/or subsequent restoration:**

J5: PLS-Zelotes B. Searls, DS, 1850, Set Or. Section Post- Sugar 12", S.41 W., 15 links, Maple 14", N.24 E., 15 links. No Subsequent Restoration prior to 1985. David B. Babbitt, RLS, 1985, Set corner mid-point on line between Southwest and Southeast section corners. Established the following references. Aspen 3", S.78 E., 18.0', Maple 6", S.09 W., 22.2', Maple 4", S.45 W., 28.0', Maple 4", S.85 W., 22.0'. Recorded in Filing No. 214, Alger County Records.


**B. Description of corner evidence found and/or method applied in restoring or reestablishing corner:**

J5: Found 1 1/4" galvanized iron pipe with 3 3/4" Aluminum cap in open area of mixed timber. Corner position was reestablished by single proportionate measurement as stated in report by David B. Babbitt, RLS, 1985. Verified references of the 1985 LCRC report and established additional reference. A search was made at GLO bearing tree locations, no evidence found. Corner position is accepted as a careful and faithful reestablishment of the position of the original corner.

**C. Description of monument for corner and accessories established to perpetuate locating the position of the corner:**

J5: Stamped P.A. 345 in existing 3 3/4" Aluminum capped Michigan D.N.R. Monument. Renewed existing reference trees w/ BT signs and paint. Established additional reference tree w/ BT signs, blazed, scribed and painted. Set PK nails for measure w/ Alum. I.D. washers in the following reference trees. Ex. Maple 7", S.89 W., 21.89 feet, " Obl. Blz'd. & scribed ", Ex. Maple 7", S.49 W., 28.29 feet, " Obl. Blz'd. and scribed ", Ex. Maple 9", S.14 W., 22.57 feet, " Obl. Blz'd. and scribed ", Cherry 6", N.15 E., 54.82 feet, " 1/4s BT ", Survey Marker sign on six foot steel post, N.74 E., 1.5 feet. All bearings are magnetic.

Signed by Robert L. Jamros  
Surveyor's Michigan License No. 25849

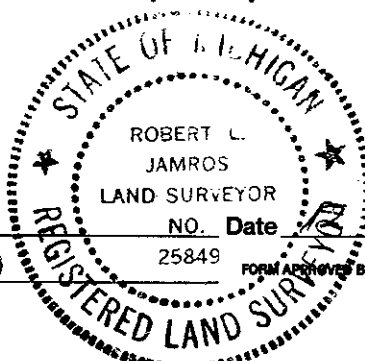

NO. Date 13 December 1995