

MICHIGAN
DEPARTMENT OF CONSERVATION
FORESTRY DIVISION

LAND CORNER RECORD

T. 46 N.R. 17W


Alger COUNTY

DESCRIPTION OF CORNER Section corner common to Sections 19, 20, 29, 30

CORNER MONUMENT Monument Box in Blacktop Road

DATE MONUMENT PLACED AND WITNESSED 8/26/60

WITNESSES TO CORNER.....

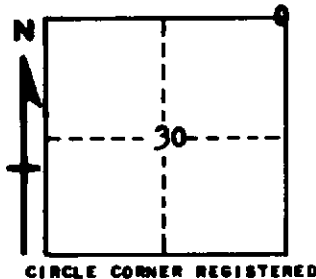

AND

DESCRIPTION IN DETAIL AS TO HOW CORNER WAS LOCATED AND IDENTIFIED OR RESTORED.

This corner was placed by Michigan State Highway Department. Corner lies 1/2
Link East of E of M-94 and in line with fence to East.

SURVEYOR'S SEAL

SIGNED Billy D. Buckler DATE 2/23/61
REGISTERED LAND SURVEYOR
Billy D. Buckler