

# SURVEY & REMONUMENTATION

JUL 30 1996

Approved by Alger County  
Land Survey Remonumentation  
Peer Group Under Act 345 of  
P.A. of 1990 On 5/8 1996

Donald W. Kinnunen  
Chairman

## COMMISSION LAND CORNER RECORDATION CERTIFICATE

4-386

Filing Requirement of Act 74, Mich. P.A. 1970

For corners in \_\_\_\_\_  
Alger (County)

Located In:

Corner Code #

FILED  
TIME 3:00 p.m.

JUN 27 1996

DONALD W. KINNUNEN  
REGISTER OF DEEDS  
ALGER COUNTY, MI

Register of Deeds Stamp & File Number

- |                                      |   |            |   |            |            |
|--------------------------------------|---|------------|---|------------|------------|
| 1. Public Land Survey                | T | <u>46N</u> | R | <u>18W</u> | <u>M7</u>  |
|                                      | T |            | R |            |            |
|                                      | T | <u>46</u>  | R | <u>17</u>  | <u>A-7</u> |
|                                      | T |            | R |            |            |
| 2. Property Controlling in Section   | S |            | T |            | R          |
|                                      | S |            | T |            | R          |
| 3. Miscellaneous Property in Section | S |            | T |            | R          |
|                                      | S |            | T |            | R          |
4. Lot No. \_\_\_\_\_, Recorded Plat \_\_\_\_\_
5. Private Claims \_\_\_\_\_

	A	B	C	D	E	F	G	H	I	J	K	L	N
2	6		5		4		3		2		1		
3													
4	7		8		9		10		11		12		
5													
6	18		17		16		15		14		13		
7													
8	19		20		21		22		23		24		
9													
10	30		29		28		27		26		25		
11													
12	31		32		33		34		35		36		
13													

I, Robert L. Jamros, in a field survey on February 08, 1996, 19\_\_\_\_\_, do hereby certify that under requirements of P.A. 74, Michigan P.A. of 1970, the corner points mentioned in lines 1 and 2 above were in conformance with regulations and rules therefore as required in the current manual of survey instructions of the United States Department of the Interior, Bureau of Land Management or by a decree of a Court of Law and/or that the corner points mentioned in lines 3, 4 and 5 above were in conformance with the rules of the Michigan Board of Professional Surveyors or by a Decree of a Court of Law; established, re-established, monumented, re-monumented, recovered, found as expressed below:

**NOTE: Not more than 4 corners, all in the same town and range, may be recorded on this certificate.**

**A. Description of original monument and accessories and/or subsequent restoration:**


M7: PLS-William A. Burt, DS, 1841, Set post corner of sections 13 & 24 - Sugar 18', S.72 W., 24 links, Sugar 10', N.30 E., 23 links.\*\*\*\* Alger County Road Commission, Field book No. 17, George L. Depew, County Surveyor, 1916, Set standard Alger County Monument, from original government BT. No references given.\*\*\*\* Robert L. Jamros, RLS, 1981, Found 2" galvanized iron pipe with brass cap missing, Raised to grade with 1/2" x 24" rebar with I.D. cap, No references given.\*\*\*\* Robert L. Jamros, RLS, 1992, Found 1/2" rebar with I.D. cap two inches below grade of pavement in centerline of percy road. Established references as follows, Maple 22', N.50 W., 52.70 feet, Maple 20', S.78 W., 43.83 feet, Maple 6', N.53 E., 67.0 feet, Maple 8', S.54 E., 45.9 feet. Filing No. 4-190, Alger County Records.

**B. Description of corner evidence found and/or method applied in restoring or reestablishing corner:**

M7: Found 1/2" Rebar with cap damaged and all of the BT's of the 1992 report in good condition. The bottom portion, 2" G.I.P., of the Alger County Standard monument, 1916, is upright and in usable condition. Measurements to existing corners South and North support the corner position. Remains of old Alger County standard monument at corner position are solid and have been accepted as a careful and faithful perpetuation of the position of the original corner.

**C. Description of monument for corner and accessories established to perpetuate locating the position of the corner:**

M7: Set in place of exist. 1/2" rebar a 5/8"x 18" rebar with Berntsen 3 1/4" aluminum cap no. RBD5325, stamped to identify corner position, grouted in place with concrete. Renewed and upgraded the following exist. reference trees with paint and BT signs.\*\* Maple 24', N.45 W., 52.70 feet, PK w/brass washer.\*\* Maple 22', S.84 W., 43.83 feet, PK w/brass washer.\*\* Maple 7", N.59 E., 67.0 feet, PK w/ aluminum I.D. washer.\*\* Maple 9", S.48 E., 45.9 feet, PK w/ aluminum I.D. washer. All bearings are magnetic.

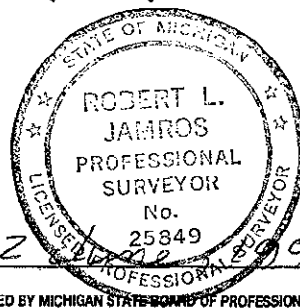

Signed by Robert L. Jamros  
Surveyor's Michigan License No. 25849

Date 12 29 1996