

DEC 27 1999

Approved by Alger County  
Land Survey Re-monumentation  
Peer Group Under Act 345 of  
P.A. of 1990 On 12-8-19-99

Harold W. Wilson  
Chairman

For corners in SECTION

LAND CORNER RECORDATION CERTIFICATE  
Filing Requirement of Act 74, Mich. P.A. 1970

05-179

Alger (County)	Located In:	Corner Code #
1. Public Land Survey	T 46N R 17W	A12 ✓
	T <del>46N</del> R <del>18W</del>	M12
	T _____ R _____	_____
	T _____ R _____	_____
2. Property Controlling in Section	S _____ T _____ R _____	_____
	S _____ T _____ R _____	_____
3. Miscellaneous Property in Section	S _____ T _____ R _____	_____
	S _____ T _____ R _____	_____

FILED  
TIME 1:30 p.m.

DEC 15 1999

DONALD W. KINNUNEN  
REGISTER OF DEEDS  
ALGER COUNTY, MI

Register of Deeds Stamp & File Number

- 4. Lot No. \_\_\_\_\_, Recorded Plat \_\_\_\_\_
- 5. Private Claims \_\_\_\_\_

	A	B	C	D	E	F	G	H	I	J	K	L	M
2	6		5		4		3		2		1		
3													
4	7		8		9		10		11		12		
5													
6	18		17		16		15		14		13		
7													
8	19		20		21		22		23		24		
9													
10	30		29		28		27		26		25		
11													
12	31		32		33		34		35		36		
13													


I, Robert L. Jamros, in a field survey on November 02, 1999, do hereby state that under requirements of P.A. 74, Michigan P.A. of 1970, the corner points mentioned in lines 1 and 2 above were in conformance with regulations and rules therefore as required in the current manual of survey instructions of the United States Department of the Interior, Bureau of Land Management or by a decree of a Court of Law and/or that the corner points mentioned in lines 3, 4 and 5 above were in conformance with the rules of the Michigan Board of Land Surveyors or by a Decree of a Court of Law; established, re-established, monumented, recovered, found as expressed below:

NOTE: Not more than 2 corners, all in the same town and range, may be recorded on this certificate.

A. Description of original monument and accessories and/or subsequent restoration:  
A12: PLS \* William A. Burt, DS, 1841. \* Set quarter section post. \* Spruce 10", S.43 E., 09 links. \* Hemlock 12", N.14 W., 41 links. \*\*\*\*\* U.S. Forest Service. \* Glenn A. Bergey, RLS, 1974. \* Found 5" Spruce with 3 blazes and a 3" Cherry with a rusted location tag. \* Unrecorded. \*\*\*\*\* No other subsequent restoration of record.

B. Description of corner evidence found and/or method applied in restoring or reestablishing corner:  
A12: Located corner search area by calculated position and standard field survey methods. Made search for evidence of GLO corner and accessories, no evidence found. Area on North-South section line and to East has been clear cut and at present is only supporting small growth. Found a Spruce 12" with 3 blazes, North, 60 feet from corner position, believed to be same 5" Spruce mentioned in U.S.F.S. report of 1974. Cherry with rusted location tag has been lost. Established corner position at mid point and on line between section corners 1/2 mile north and 1/2 mile south. Corner position as monumented is accepted as a careful and faithful reestablishment of the position of the original corner.

C. Description of monument for corner and accessories established to perpetuate locating the position of the corner:  
A12: Set 2 1/2"x30" Berntsen aluminum monument No. A1NB30 with 3 1/4" aluminum cap stamped to identify corner position. \* Established the following reference trees with BT signs, blazed, scribed and painted. \* Set PK nails with aluminum I.D. washers for measure in the following: Balsam 3", N.38 E., 10.69 feet, "BT". \* Balsam 5", S.60 E., 12.22 feet, "BT". \* Maple 7", S.71 W., 11.34 feet, "1/4s BT". \* Spruce 3", N.63 W., 13.89 feet, "BT". \* Survey marker sign on 6 foot steel post, S.24 W., 1.0 feet. \* All bearings are magnetic.

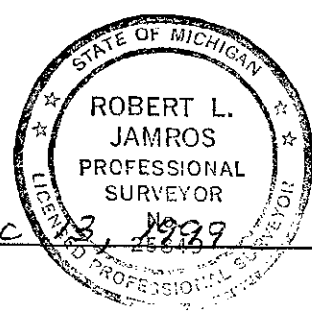

Signed by Robert L. Jamros  
Surveyor's Michigan License No. 25849

Date Dec 13, 1999