

Harold Carlson
 Chairman

LAND CORNER RECORDATION CERTIFICATE
 Filing Requirement of Act 74, Mich. P.A. 1970


5-04

For corners in ALGER (County) Located In: Corner Code #

1. Public Land Survey	T	<u>46N</u>	R	<u>17W</u>	<u>81</u>
	T	<u>47N</u>	R	<u>17W</u>	<u>B13</u>
	T		R		
	T		R		
2. Property Controlling in Section	S		T		
	S		T		
3. Miscellaneous Property in Section	S		T		
	S		T		

4. Lot No. _____, Recorded Plat _____
 5. Private Claims _____

FILED
 TIME 2:00 pm.
 MAR 31 1997
 DONALD W. KENNEDY
 REGISTER OF DEEDS
 ALGER COUNTY, MI
 Register of Deeds Stamp & File Number

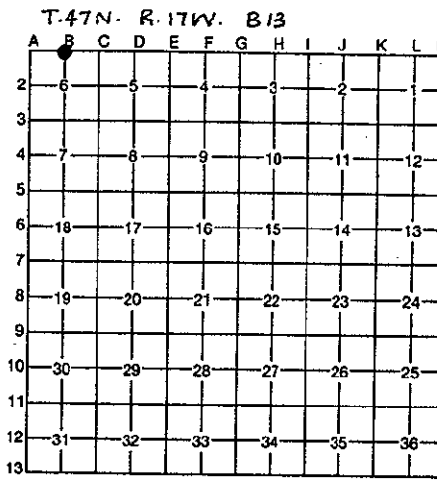

I, Robert L. Jamros, in a field survey on October 31, 1996, 19_____, do hereby certify that under requirements of P.A. 74, Michigan P.A. of 1970, the corner points mentioned in lines 1 and 2 above were in conformance with regulations and rules therefore as required in the current manual of survey instructions of the United States Department of the Interior, Bureau of Land Management or by a decree of a Court of Law and/or that the corner points mentioned in lines 3, 4 and 5 above were in conformance with the rules of the Michigan Board of Professional Surveyors or by a Decree of a Court of Law; established, re-established, monumented, re-monumented, recovered, found as expressed below:

NOTE: Not more than 4 corners, all in the same town and range, may be recorded on this certificate.

A. Description of original monument and accessories and/or subsequent restoration:

B1: PLS - William A. Burt, DS, 1841, Set quarter Section post * Maple 16, N.73 E., 14 links * Hemlock 12, N.50W., 15 links. ***** W.W. Gleason, CS, 1913. * Set standard iron corner from original notes. * No references ties given. ***** M.S.H.D., Project No. 02022, 1958. * State highway M-94. Corner position shown at Station 182+88, no ties or monument material shown. ***** Robert F. Cambensy, RLS, 1995. * Found 3/4" Iron pin in monument box, centerline H-58 at intersection of centerline Olson Road South. * Replaced with 5/8" X 40" iron rod w/ cap #19616. * Orange "Survey Witness" washers and nails in, * P.Pole, N.51 E., 50.65 feet, * 24" Maple, N.75 E., 110.15 feet, * 12" Maple, N.13 E., 48.00 feet, * 12" Tamarack, N.67 W., 140.17 feet. * Recorded in L.4, P.266, Alger County Records.

B. Description of corner evidence found and/or method applied in restoring or reestablishing corner:


B1: Found 5/8" iron rod w/ cap #19616 in monument box centerline of H-58 at centerline of Olson Road. Replaced existing cap with aluminum cap stamped to identify corner position. Located reference trees of 1995 report, all in good condition. Measurements to corners West and East check very well with highway stationing of 1958. M.S.H.D. project. Monument at existing corner position as found is accepted as the best available evidence of the position of the original corner.

SURVEY & MONUMENTATION
 AUG 15 1997
 COMMISSION

C. Description of monument for corner and accessories established to perpetuate locating the position of the corner:

B1: Replaced existing cap with Berntsen 3 1/4" aluminum cap no. RB05325, stamped to identify corner position. * Renewed three existing reference objects and added one additional reference tree, blazed, scribed and painted. * Exist. BT, P.Pole, S.51 E., 50.67 feet to an existing nail, Scribed "BT". * Exist. BT, Tamarack 12", N.66 W., 140.07 feet to an existing nail, BT signs, blazed, scribed and painted, "1/4S BT". * Exist. BT, Maple 12", N.13 E., 47.96 feet to an existing nail, Exist. lower blaze. * W. Pine 20", S.63 W., 110.23 feet to a PK nail w/ aluminum I.O. washer, BT signs, Blazed, scribed and painted, "1/4S BT". * All bearings are magnetic.

Signed by Robert L. Jamros
 Surveyor's Michigan License No. 25849

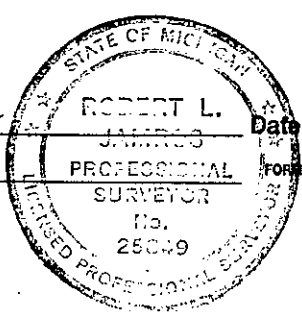

Date 25 March, 1997