

**SURVEY &
REMONUMENTATION**

FEB 19 1998

Approved by Alger County
Land Survey Remonumentation
Peer Group Under Act 313 of
P.A. of 1990 On 12-10-1997

SECTION

05-69

Donald W. Kinnunen
Chairman

LAND CORNER RECORDATION CERTIFICATE
Filing Requirement of Act 74, Mich. P.A. 1970

For corners in _____

(County)

Located In:

Corner Code #

- | | | | | | |
|--------------------------------------|---|-----------|---|-----------|-----------|
| 1. Public Land Survey | T | <u>46</u> | R | <u>17</u> | <u>B2</u> |
| | T | _____ | R | _____ | _____ |
| | T | _____ | R | _____ | _____ |
| | T | _____ | R | _____ | _____ |
| 2. Property Controlling in Section | S | _____ | T | _____ | _____ |
| | S | _____ | T | _____ | _____ |
| 3. Miscellaneous Property in Section | S | _____ | T | _____ | _____ |
| | S | _____ | T | _____ | _____ |

FILED
TIME 8:30 A.M.


DEC 17 1997

DONALD W. KINNUNEN
REGISTER OF DEEDS
ALGER COUNTY, MI

Register of Deeds Stamp & File Number

4. Lot No. _____, Recorded Plat _____
5. Private Claims _____

I, Robert L. Jaaros, in a field survey on November 16, 1997, 19_____, do hereby certify that under requirements of P.A. 74, Michigan P.A. of 1970, the corner points mentioned in lines 1 and 2 above were in conformance with regulations and rules therefore as required in the current manual of survey instructions of the United States Department of the Interior, Bureau of Land Management or by a decree of a Court of Law and/or that the corner points mentioned in lines 3, 4 and 5 above were in conformance with the rules of the Michigan Board of Professional Surveyors or by a Decree of a Court of Law; established, re-established, monumented, re-monumented, recovered, found as expressed below:

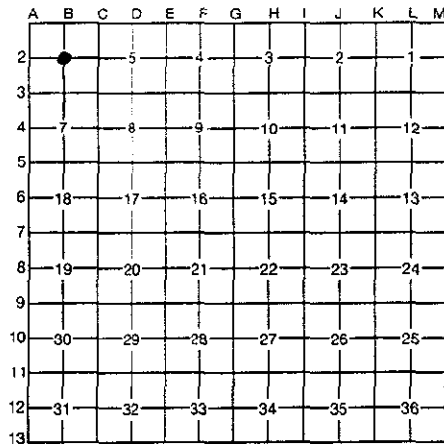

NOTE: Not more than 4 corners, all in the same town and range, may be recorded on this certificate.

A. Description of original monument and accessories and/or subsequent restoration:
B2: PLS - Corner position not established by original government surveyors.

B. Description of corner evidence found and/or method applied in restoring or reestablishing corner:
B2: Corner position established by survey in 1946 by Edwin Swan, RLS * Corner position was set North of South quarter corner on line with North quarter corner at a distance equal to the South half of the East line of Section 6 * The East-West quarter line was then extended West of the East half of Section 6 by an angle from the North-South quarter line * Distance from the North-South quarter line to a falling of 6.0 feet South of 2 inch squared stake marking corner on range line was 2432 feet * Corner position lies 4.7 feet South and 0.2 feet East of the true intersection of quarter lines * Property surveys in this area have accepted and used this monument position since 1944 * This monument position is accepted as the best available evidence of the position of the corner.

C. Description of monument for corner and accessories established to perpetuate locating the position of the corner:
B2: Set 5/8 inch by 18 inch Rebar w/Berntsen Alum. cap no. R8D 532S at position of 1 inch iron bar * Renewed Exist. BT's w/BT signs and established additional reference trees w/BT signs, blazed and scribed * Set PK nails w/Alum. I.D. washers in the following - Exist. BT, Cedar 6, S.72 W., 38.30 feet to exist. nail, "NBT" * Exist. BT, Cedar 8, N.23 W., 70.50 feet to exist. nail "NBT" * Spruce 8, S.63 E., 47.90 feet, "BT" * White Birch 8, N.68 E., 47.40 feet, "BT" * On centerline of exist. road * All bearings are magnetic.

Signed by Robert L. Jaaros
Surveyor's Michigan License No. 25849

Date 12/10/1997

