

**LAND CORNER RECORDATION CERTIFICATE**  
 Filing Requirement of Act 74, Mich. P.A. 1970

5-08

Herold Carlson  
 Chairman

For corners in Alger Located In: \_\_\_\_\_ Corner Code # \_\_\_\_\_  
 (County)

1. Public Land Survey	T	<u>46N</u>	R	<u>17W</u>	<u>85</u>
	T	_____	R	_____	_____
	T	_____	R	_____	_____
	T	_____	R	_____	_____
2. Property Controlling in Section	S	_____	T	_____	_____
	S	_____	T	_____	_____
3. Miscellaneous Property in Section	S	_____	T	_____	_____
	S	_____	T	_____	_____

4. Lot No. \_\_\_\_\_, Recorded Plat \_\_\_\_\_  
 5. Private Claims \_\_\_\_\_

**FILED**  
 TIME 2:00 pm  
**MAR 31 1997**  
**DONALD W. KINNUNEN**  
 REGISTER OF DEEDS  
 ALGER COUNTY, MI  
 Register of Deeds Stamp & File Number

A	B	C	D	E	F	G	H	I	J	K	L	M
2	6	5	4	3	2	1						
3												
4	7	8	9	10	11	12						
5	•											
6	18	17	16	15	14	13						
7												
8	19	20	21	22	23	24						
9												
10	30	29	28	27	26	25						
11												
12	31	32	33	34	35	36						
13												

I, Robert L. Jamros, in a field survey on October 31, 1996, 19\_\_\_\_\_, do hereby certify that under requirements of P.A. 74, Michigan P.A. of 1970, the corner points mentioned in lines 1 and 2 above were in conformance with regulations and rules therefore as required in the current manual of survey instructions of the United States Department of the Interior, Bureau of Land Management or by a decree of a Court of Law and/or that the corner points mentioned in lines 3, 4 and 5 above were in conformance with the rules of the Michigan Board of Professional Surveyors or by a Decree of a Court of Law; established, re-established, monumented, re-monumented, recovered, found as expressed below:

**NOTE: Not more than 4 corners, all in the same town and range, may be recorded on this certificate.**

**A. Description of original monument and accessories and/or subsequent restoration:**

85: P.L.S., William Ives, DS, 1850. \* Set qr. Section post. \* Ironwood 6, N.01W., 15 links. \* Sugar 10, S.14E., 28 links. \*\*\*\* No other subsequent restoration.

**B. Description of corner evidence found and/or method applied in restoring or reestablishing corner:**


85: Found bent 1/2" iron deep below surface of asphalt road on line and at proportional distance between Section corners East and West. Author unknown. Corner lies 1.3 feet North of centerline of asphalt road. Found evidence of fence line to the South and occupation to the North of corner position. Major stream call to the West, GLO 13.30 chains, measured at 13.25 chains. Existing monument as found is accepted as a careful and faithful reestablishment of the position of the original corner.

**SURVEY &  
 REMONUMENTATION**  
**AUG 15 1997**  
**COMMISSION**

**C. Description of monument for corner and accessories established to perpetuate locating the position of the corner:**

85: Replaced existing 1/2" rebar with a 5/8" x 18" rebar with Bernsten cap no. RBD 5325, stamped to identify corner position. Established reference objects with BT signs, blazed, scribed, and painted as noted. Set PK nails with Aluminum I.O. washers for measure in the following reference objects. \* P. Pole, N.57 W., 61.18 feet, scribed 'BT' at base. \* 8" Maple, S.51 E., 63.61 feet, BT signs, scribed, '1/4S. BT', and painted. \* 4" Spruce, S.53 W., 51.77 feet, scribed 'BT' at base and painted. \* 5" Spruce N.49 E., 49.19 feet, scribed 'BT' at base and painted. \* All bearings are magnetic.

Signed by Robert L. Jamros  
 Surveyor's Michigan License No. 25849

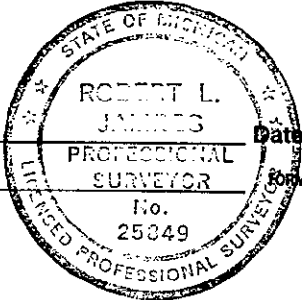

Date 25 March 1997