

Harold Carlson
 Chairman

LAND CORNER RECORDATION CERTIFICATE
Filing Requirement of Act 74, Mich. P.A. 1970

5-07


For corners in ALGER (County) Located In: Corner Code #

1. Public Land Survey	T	<u>46N</u>	R	<u>17W</u>	<u>C6</u>
	T		R		
	T		R		
	T		R		
2. Property Controlling in Section	S		T	R	
	S		T	R	
3. Miscellaneous Property in Section	S		T	R	
	S		T	R	

4. Lot No. _____, Recorded Plat _____
 5. Private Claims _____

FILED
 TIME 2:00 p.m.
MAR 31 1997
DONALD W. KINNUNEN
 REGISTER OF DEEDS
 ALGER COUNTY, MI
Register of Deeds Stamp & File Number

I, Robert L. Jamros, in a field survey on October 31, 1996, 19_____, do hereby certify that under requirements of P.A. 74, Michigan P.A. of 1970, the corner points mentioned in lines 1 and 2 above were in conformance with regulations and rules therefore as required in the current manual of survey instructions of the United States Department of the Interior, Bureau of Land Management or by a decree of a Court of Law and/or that the corner points mentioned in lines 3, 4 and 5 above were in conformance with the rules of the Michigan Board of Professional Surveyors or by a Decree of a Court of Law; established, re-established, monumented, re-monumented, recovered, found as expressed below:

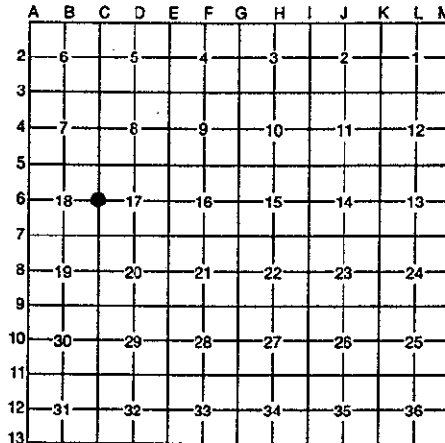

NOTE: Not more than 4 corners, all in the same town and range, may be recorded on this certificate.

A. Description of original monument and accessories and/or subsequent restoration:

C6: PLS - William Ives, DS, 1850, Set quarter Section post * Fir 10, N.80 E., 1 link * Cedar 22, S.75 W., 8 links ***** W.W. Gleason, CS, 1913. * Set Standard Iron Corner from original field notes. * No references given. ***** M.S.H.D., Project No. 02022, 1958. * Corner shown on construction plans. * No references or monument material shown. ***** Robert L. Jamros, RLS, 1980. * Corner position located by field survey. * Found remains of badly damaged 2" G.I.P. lying horizontal in road fill approximately 20 feet NE'ly of corner position. * Set final corner position proportionately on line between Section corners 1/2 mile South and North. * References, 8" Hemlock, S.73 E, 39.2 feet, * 10" Hemlock, S.79 W., 34.6 feet * 10" Hemlock, N.32 E., 83.0 feet, * 1 1/4" Iron Pipe, N. 81 W., 31.8 feet. * Recorded in L.3, P. 351, Alger County Records.

B. Description of corner evidence found and/or method applied in restoring or reestablishing corner:

C6: Found 1/2" rebar w/ cap in asphalt road 2.2 feet West of centerline of asphalt and three existing BT's of the 1980 Report. Measurements to section corners South and North are acceptable. Monument at existing corner position is accepted as a careful and faithful reestablishment of the position of the original corner.

SURVEY & REMONUMENTATION


AUG 15 1997

COMMISSION

C. Description of monument for corner and accessories established to perpetuate locating the position of the corner:

C6: Replaced existing 1/2" rebar with a 5/8" X 18" Rebar with Berntsen cap no. RBD5325, stamped to identify corner position. Renewed existing reference trees with BT signs and paint. Established additional reference tree with BT signs, Blazed, Scribed and Painted. Set PK nails with aluminum I.D. washers for measure in the following reference objects. * Exist. BT, Spruce 12", S.85 W., 34.58 feet, Breast Height Blaze. * Exist. BT, Spruce 11", S.69 E., 39.31 feet, Breast Height Blaze. * Exist. BT, P.Pole, N.23 W., 48.72 feet, Scribed "BT" in base. * Balsam 5", N.60 E., 62.81 feet, Scribed through bark, "1/4S BT". * All bearings are magnetic.

Signed by Robert L. Jamros
 Surveyor's Michigan License No. 25849

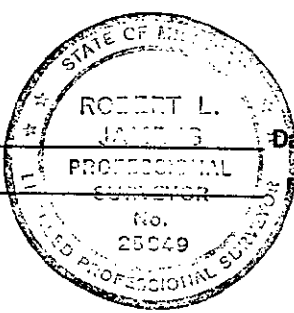

Date 25 March, 1997