

REMONUMENTATION

FEB 19 1998

Approved by Alger County
Land Survey Remonumentation
Peer Group Under Act 245 of
P.A. of 1990 Ch 1210 1997

SECTION

05-59

Gerald W. Carlson
Chairman

LAND CORNER RECORDATION CERTIFICATE

Filing Requirement of Act 74, Mich. P.A. 1970

For corners in

(County)	Located In:	Corner Code #
	46 17	C10
1. Public Land Survey	T <u> </u> R <u> </u>	<u> </u>
	T <u> </u> R <u> </u>	<u> </u>
	T <u> </u> R <u> </u>	<u> </u>
	T <u> </u> R <u> </u>	<u> </u>
2. Property Controlling in Section	S <u> </u> T <u> </u> R <u> </u>	<u> </u>
	S <u> </u> T <u> </u> R <u> </u>	<u> </u>
3. Miscellaneous Property in Section	S <u> </u> T <u> </u> R <u> </u>	<u> </u>
	S <u> </u> T <u> </u> R <u> </u>	<u> </u>


FILED
TIME 8:30 Am

DEC 17 1997

DONALD W. KINNUNEN
REGISTER OF DEEDS
ALGER COUNTY, MI

Register of Deeds Stamp & File Number

- 4. Lot No. _____, Recorded Plat _____
- 5. Private Claims _____

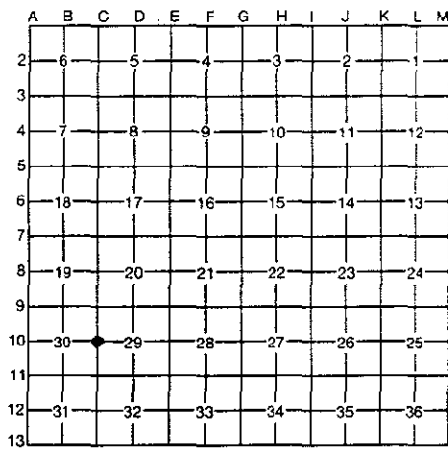

I, Robert L. Jamros, in a field survey on November 08, 1977, 19 _____, do hereby certify that under requirements of P.A. 74, Michigan P.A. of 1970, the corner points mentioned in lines 1 and 2 above were in conformance with regulations and rules therefore as required in the current manual of survey instructions of the United States Department of the Interior, Bureau of Land Management or by a decree of a Court of Law and/or that the corner points mentioned in lines 3, 4 and 5 above were in conformance with the rules of the Michigan Board of Professional Surveyors or by a Decree of a Court of Law; established, re-established, monumented, re-monumented, recovered, found as expressed below:

NOTE: Not more than 4 corners, all in the same town and range, may be recorded on this certificate.

A. Description of original monument and accessories and/or subsequent restoration:

C10: PLS - William Ives, DS, 1850 * Set quarter section post * Yellow Birch 14, S.20 W., 7 links * Fir 9, N.28 E., 30 links **** George L. Depew, County Surveyor, 1917 * Set standard iron corner between corners on true line * No references **** Michigan State Highway Department Right of Way Maps, Project 1-17A, 1959-1961 * Corner position not shown **** Land Corner Record, M.D. of C. * Bill, C. Buckler, 1960 * Corner position in monument box, 1 1/2 links West of centerline of M-94 and 54 links North of East-West power line * No references given * Recorded in Liber 2, Page 165, Alger County Corner Records **** Robert L. Jamros, RLS, 1980 * Found galv. iron pipe w/brass cap in monument box, 0.90 feet west of centerline of pavement and North of overhead transmission lines * Witnesses - Tamarack 20, N.60 E., 71.5 feet * Power Pole, S.25 W., 73.6 feet * Northeast corner of Chain Link Fence, S.66 W., 79.3 feet * Apple 12, S.32 E., 66.3 feet * Recorded in Liber 3, Page 343, Alger County Corner Records **** Gerald W. Carlson, RLS, 1992 * Found iron in monument box, 1.0 feet West of centerline of M-94 and 35.6 feet North of centerline of East-West powerline * Recorded in Liber 4, Page 18, Alger County Corner Records **** No other subsequent restoration.

B. Description of corner evidence found and/or method applied in restoring or reestablishing corner:

C10: Found Alger County standard corner in monument box, 0.90 feet West of centerline of pavement of County Road H-15 and 34.6 feet North of East-West power line * Monument position was reestablished in 1917 by George L. Depew and the position remains within the standards of his survey * Corner position measures well between corners North and South and is 1.5 feet West of true line between corners * Monument position in monument box is accepted as a careful and faithful reestablishment of the position of the original corner.

C. Description of monument for corner and accessories established to perpetuate locating the position of the corner:

C10: Alger County standard corner (1917), brass cap as stamped to identify corner position in monument box, 0.90 feet West of centerline pavement and 34.6 feet North of centerline of power line * Renewed exist. BT's and established additional references with B' signs, blazed and scribed * Set PK nails w/1/2" I.D. washers for measure in 3 of the following - Exist. BT, Spruce 24, (was Tamarack 20) N.67 E., 71.33 feet, '1/4S BT' * Maple 3, N.28 W., 91.53 feet, '1/4S BT' * Exist. BT, Northeast corner of Chain Link Fence, S.66 W., 79.35 feet * Exist. BT, Power Pole, S.21 W., 72.68 feet, scribed BT in base * All bearings are magnetic.

Signed by Robert L. Jamros
Surveyor's Michigan License No. 25049

Date 12/10/1997

