

SURVEY & REMONUMENTATION

FEB 19 1998

Approved by Peer County Land Surveyor Remonumentation Peer Group under Act 313 of P.A. of 1970 C-12-10-19-97

SECTION

05-58

LAND CORNER RECORDATION CERTIFICATE

Filing Requirement of Act 74, Mich. P.A. 1970

For corners in

Table with columns: Located In: (Town, Range, Section), Corner Code #, and a list of corner types (Public Land Survey, Property Controlling, etc.) with corresponding T/R/S codes.

FILED TIME 8:30 A.M.

DEC 17 1997

DONALD W. KINNUNEN REGISTER OF DEEDS LAGER COUNTY, MI

Register of Deeds Stamp & File Number

4. Lot No. , Recorded Plat
5. Private Claims

Grid table with columns A-M and rows 1-13, used for recording corner locations.

I, Robert James, in a field survey on November 24, 1997, 19 do hereby certify that under requirements of P.A. 74, Michigan P.A. of 1970, the corner points mentioned in lines 1 and 2 above were in conformance with regulations and rules therefore as required in the current manual of survey instructions of the United States Department of the Interior, Bureau of Land Management or by a decree of a Court of Law and/or that the corner points mentioned in lines 3, 4 and 5 above were in conformance with the rules of the Michigan Board of Professional Surveyors or by a Decree of a Court of Law; established, re-established, monumented, re-monumented, recovered, found as expressed below:

NOTE: Not more than 4 corners, all in the same town and range, may be recorded on this certificate.

A. Description of original monument and accessories and/or subsequent restoration:

C11: PLS - Wa.Lees, DS,1950 * Set post cor. of Sec. 29,30,31 & 32 * Mem 12 E.12 W. 28 1k.* Mem 14 N.57 E. 31 1k.*** MI Tele. Map, 1899 * Graphical loc. only *** D.S.S.A. Ry.Co.* R/W Map, 6/30/16 * Cor. pos. btwn. trks.*** Geo. L. Depew, 18, 1917, Set std. iron cor *** M.D.S.H. R/W Maps, 1959 * Fnd. 2"IP w/BC * Wit.,T.P.,N.28 W.,59.23' * T.P.,N.24 E.,67.79' * T.P., S.44 E.,48.62' *** R.L.Jamros, PLS,1980 * Cor. mon. destroyed * Reestab. cor. pos. by wit.,M.D.S.H. R/W Maps,1959 * Chiseled hole 1" deep in conc.* Wit. - T.P.,N. 28 E.,84.43' * Sledge of S.rail, main trk.,N.2.45' * S.E.cor.bldg.,N.48 W.,97.34' * N.W.Cor.Conc.Wall,S.33 E.,139.23' * Rec.in L.1,P.404 & L.3, P.348, A.C.Cor.Rec.*** G.W.Carlson,RLS,1982 * Found hole in conc.* Same wit.as 1980 report * Rec.in L.4,P.18, A.C.Cor.Rec.*** G.E.Koepke,RLS,1990 * Set 1/2"RB * Wit. S.50 E.,48.34',P.P.* N.00 E.,69.49', T.P.* N.40 W.,98.55',N.E.Cor.Bldg.* N.50 W.,29.45',chiseled 'X' in S.W. bolt of R/R signal * Rec.in L.4, P.7, A.C. Cor. Rec.


B. Description of corner evidence found and/or method applied in restoring or reestablishing corner:

C11: Found 1 1/2" Rebar w/I.D. cap in monument box, 2.45 feet South of South rail of railroad main track * Corner position shares same location as brass cap set in 1917 by George L. Depew * Brass cap was destroyed at time concrete filler strips were installed in railroad track. * 1 witness and other accessories of the M.D.S.H. plans of 1959-61 perpetuated this position - Telephone Pole, S.44 E., 48.62 feet and tie of 2.45 feet to South rail of railroad * Corner position has been accepted and used in area surveys. * Monument box and corner position are accepted as the best available evidence of the position of the original corner.

C. Description of monument for corner and accessories established to perpetuate locating the position of the corner:

C11: Replaced 1 1/2" Rebar with 5/8"x18" Rebar w/Bernsten Alum. cap no. RBD 5325, stamped to I.D. cor. pos. * Remeasured exist. refer. as fol. - P. Pole, S. 39 E., 48.34' * N.E. Cor. of Bldg., N.35 W., 98.55' * Chiseled 'X', S.W. bolt of R/R signal, N. 44 W., 29.45' * S.E. Cor. Bldg., N.40 W., 97.34' * T. Pole, N.35 E., 84.43'.

Signed by Robert James Surveyor's Michigan License No. 25849

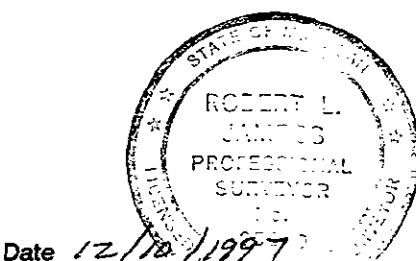

Date 12/10/1997